IREDELL COUNTY HEALTH DEPARTMENT

STATESVILLE 704-878-5305 MOORESVILLE 704-664-5281

IMPROVEMENT PERMIT / AUTHORIZATION TO CONSTRUCT / OPERATION PERMIT / EXISTING SYSTEM INSPECTION

PERMIT# 81363 PIN# 4742485258 DATE 5-25-99

OWNER OR CONTRACTOR George White PHONE: Business 660 6575 Home

ADDRESS 274 Yacht Rd Mooresville, N.C.

LOCATION Amity Hill TR Duck Creek TR Wintergreen

SUBDIVISION BLOCK / SECTION LOT LOT AREA 1.55 acres SITE CLASS PS DESIGN FLOW 360 L.T.A.R. .3

Septic Tank: 1000 Gallons; STB 1012 Date 10-10-99
Pump Tank: Gallons; PT Date
Pump Make: Model Serial No.
Nitrification Field: No Fields 1 Square Feet 1200 Linear Feet 400
No Lines 4 Trench Width 36" Max Trench Bottom Depth 36" Gravel Depth 12"

☑ New System ☐ Repair System Type: I, II, III, IV, V, VI
System Description: Conv. Gravity
Repair System Description: Gravity 25% Reduction
Maintenance Agreement Required: ☐ Yes ☐ No


☑ House/Mod. Home ☐ Mobile Home ☐ Business ☐ Other
No. Bedrooms 3 No. Bathrooms 2 No. Employees
☐ Slab ☐ Crawl Space ☑ Basement w/plumbing ☐ Basement wo/plumbing

Water Supply: ☑ Individual ☐ Public ☐ Community

Comments:/Conditions: Replace issued To Fredrick Morrison 4-20-99

Comments:/Conditions:

INITIAL SITE SKETCH

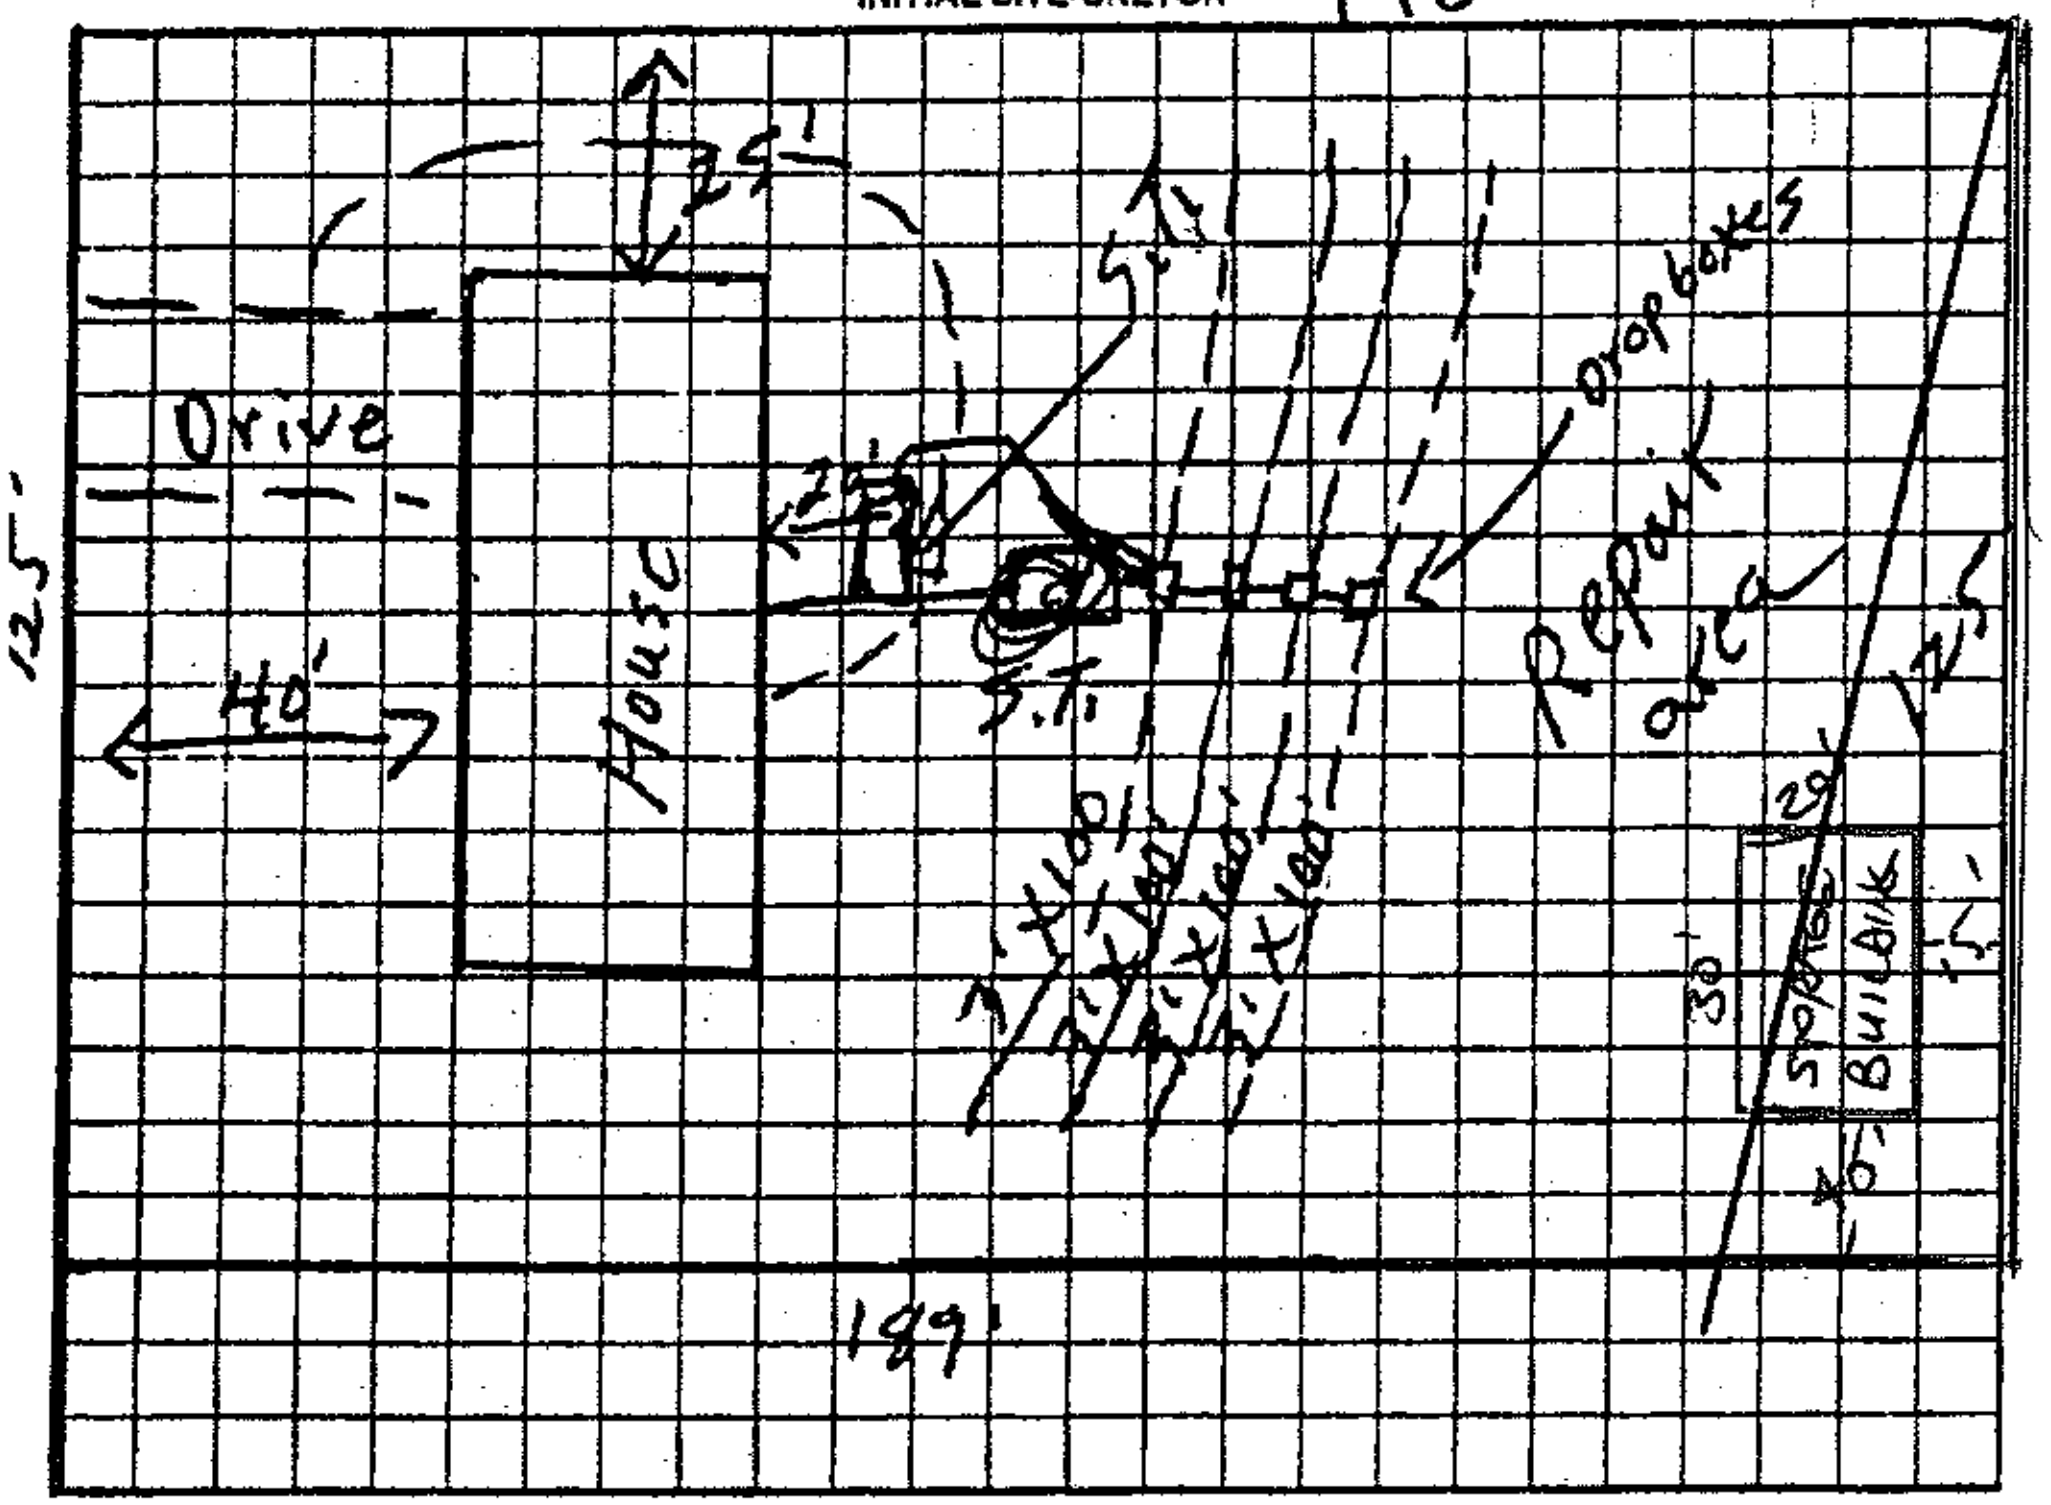

AS BUILT SKETCH

Same as initial sketch except S.T. position

No Driveway to back was installed

Location of the proposed STORAGE BUILDING addition does not appear to impact the existing on-site septic system.**NOTE: KEEP MIN. 5' FROM REPAIR
R. STEVE HEDRICK REHS
Date: OCTOBER 11, 2012
ICHD-Environmental Health Division

Permit can be suspended or revoked if any false information is supplied toward securing the permit/any unauthorized changes are made to the site/any unauthorized changes are made in the installation of the system. Improvement Permit with plat valid without expiration. Improvement Permit with site plan valid for sixty months. Authorization to Construct is valid for a period equal to that of Improvement Permit – not to exceed sixty months.

Signed: [signature] date Installed by: Richard Abernathy

Improvement Permit by: L.C. Moore date 5-25-99 Operation Permit by: L.C. Moore date 1-14-00

Authorization to Construct by: L.C. Moore date 5-25-99 Existing System Inspection by: date

HEALTH DEPT. COPY: WHITE OWNER COPY (FINAL) YELLOW OWNER COPY (INITIAL) PINK