IREDELL COUNTY HEALTH DEPARTMENT - *ENVIRONMENTAL HEALTH* ☒ STATESVILLE OFFICE 704-878-5305 ☐ MOORESVILLE OFFICE 704-664-5281

IMPROVEMENT PERMIT / AUTHORIZATION TO CONSTRUCT / OPERATION PERMIT / EXISTING SYSTEM INSPECTION

PERMIT # 174076 PIN # 4742549697 DATE 8-13-12

OWNER Sheldon Murdock APPLICANT: Morton Building PHONE: Home/Cell # 336 249 0490 Business #

SITE ADDRESS 601 Murdock Rd OWNER / APPLICANT ADDRESS 601 Murdock Rd.

SITE DIRECTIONS 77S, Exit on 45, (R) on Amity Hill Rd., (L) Murdock Rd., on (R)

SUBDIVISION n/a BLOCK / SECTION n/a LOT # n/a LOT AREA 35.342 DESIGN FLOW 360 Ex L.T.A.R. Ex

Septic Tank Ex Gallons: STB Ex Date

Pump Tank Gallons: P T Date

Pump Make Model Serial #

No. Nitrification Fields: 2 No. Lines Ex Linear Feet Ex

Trench Width Ex Max. Trench Bottom Depth Ex Gravel Depth Ex

☐ New System ☐ Repair ☐ Expansion System Type I (II) III IV V VI

System Description: Gravel Conventional

Repair System Description:

Maintenance Agreement Required ☐ YES ☒ NO

☒ GRAVITY ☐ PRESSURE

☒ Residence No. Bedrooms Ex Ex

☐ Business No. Persons

☐ Other No. Employees

☐ Slab ☒ Crawl Space


☐ Basement w/plumbing ☐ Basement w/o plumbing

Water Supply: ☒ Private ☐ Public ☐ Community


Comments / Conditions

Area For New 30' x 40' garage does not appear to impact any septic or well locations

INITIAL SITE SKETCH

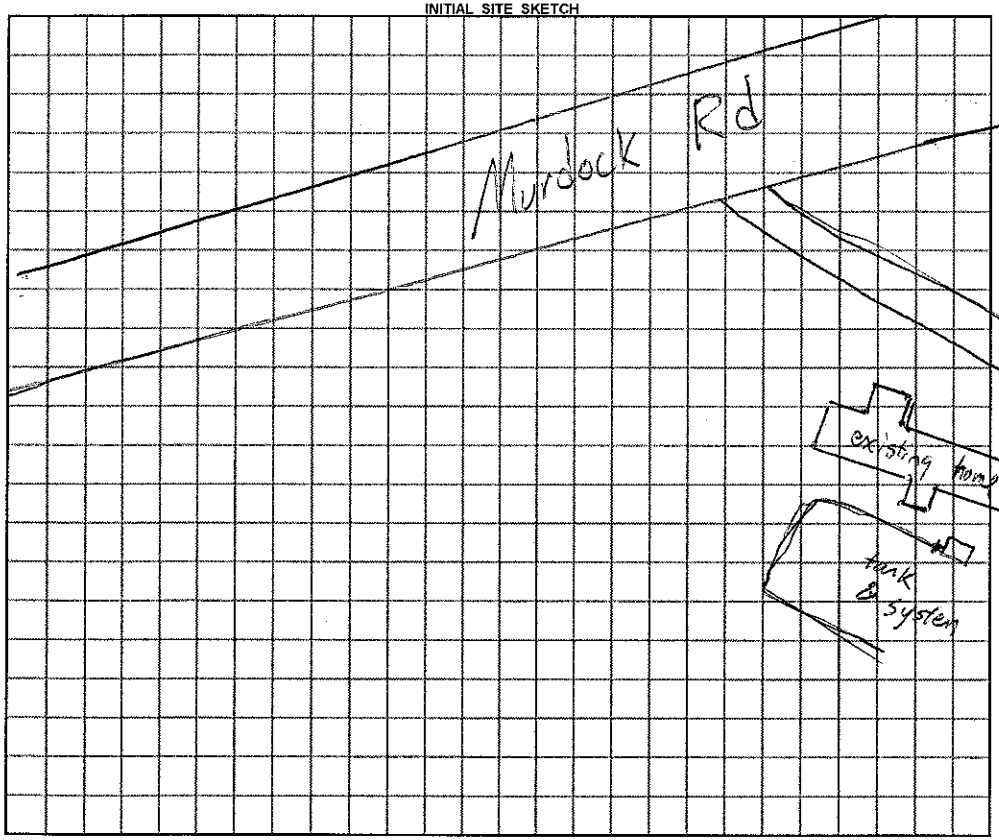

AS BUILT SKETCH

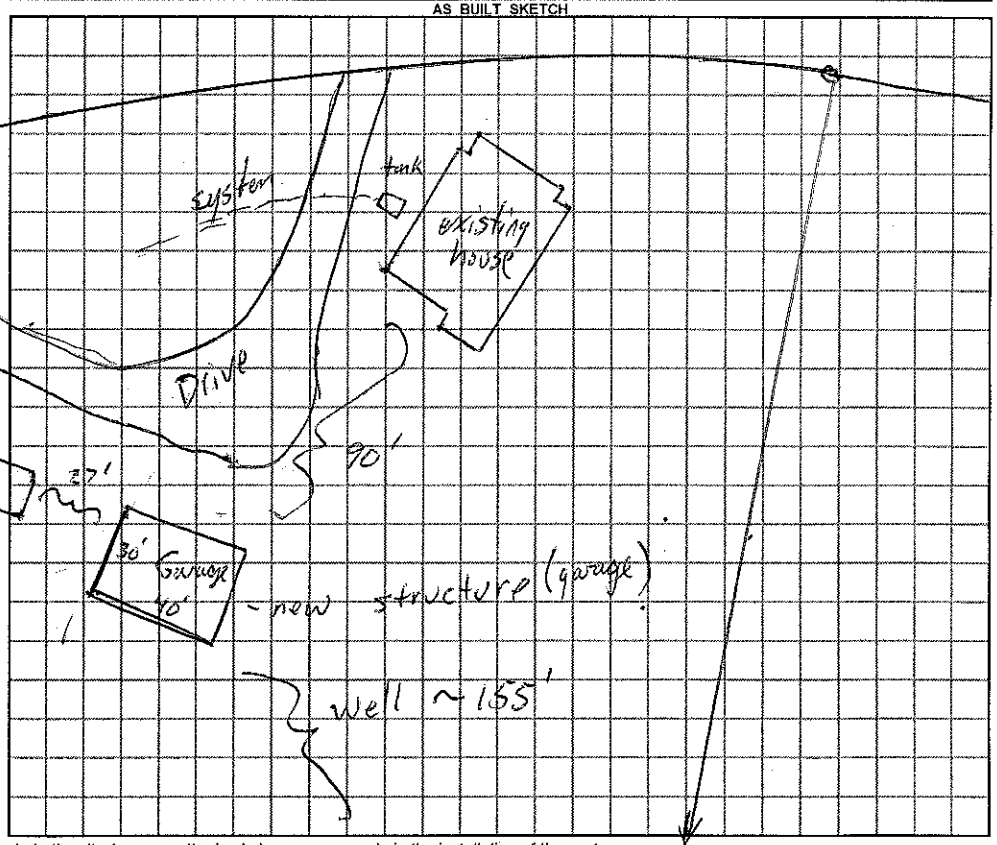

Permit can be suspended or revoked if any false information is supplied toward securing the permit / any unauthorized changes are made to the site / any unauthorized changes are made in the installation of the system.

☐ ***IMPROVEMENT PERMIT*** *with plat valid without expiration.* ☐ ***IMPROVEMENT PERMIT*** *with plat valid without expiration. site plan valid 60 mo.* ☐ ***AUTHORIZATION TO CONSTRUCT*** valid for period equal to IMPROVEMENT PERMIT--not to exceed 60 mo.

Owner / Applicant Signature: Date

IMPROVEMENT PERMIT by: REHS Date

AUTHORIZATION TO CONSTRUCT by: REHS Date

YOU SHOULD CONTACT A LOCATOR SERVICE PRIOR TO ANY EXCAVATION

Installed by:

OPERATION PERMIT by: REHS Date

Existing System Inspected by: REHS Date 8-13-12

White Copy -- Environmental Health YELLOW COPY (Final) Owner / Applicant PINK COPY (Initial) Owner / Applicant