IREDELL COUNTY HEALTH DEPARTMENT

STATESVILLE 704-878-5305 MOORESVILLE 704-664-5281

IMPROVEMENT PERMIT / CERTIFICATE OF COMPLETION / OPERATION PERMIT / EXISTING SYSTEM INSPECTION

PROPERTY DESCRIPTION NO. 69329 DATE 9-9-97 TAX MAP NO. 4742568178 Watershed: ☐ Yes ☐ No

OWNER OR CONTRACTOR Robert B. Hall PHONE: Business Home 704 838 0622

ADDRESS 128 Suzuki Dr. Troutman, N.C.

LOCATION Murdock Rd TR Hamilton TR Suzuki on Rt

SUBDIVISION Silo Acres BLOCK / SECTION LOT 102 LOT AREA 29,000 sq SITE CLASS. PS DESIGN FLOW 360 L.T.A.R. 133

Septic Tank: 1000 Gallons; STB Date

Pump Tank: Gallons; PT Date

Pump Make: Model Serial No.

Nitrification Field: No Fields 1 Square Feet 1080 Linear Feet 360

No Lines 3 Trench Width 36" Max Trench Bottom Depth 36" Gravel Depth 12"

☐ New System ☐ Repair System Type: I, II, III, IV, V, VI

System Description: Conv. Gravity

Repair System Description:

Maintenance Agreement Required: ☐ Yes ☐ No

☐ House/Mod. Home No. Bedrooms 3

☐ Mobile Home No. Bathrooms 2

☐ Business No. Employees

☐ Other


☐ Slab ☐ Crawl Space ☐ Basement w/plumbing ☐ Basement wo/plumbing

Water Supply: ☐ Individual ☐ Community ☐ Public


Comments:

Comments:

INITIAL SITE SKETCH

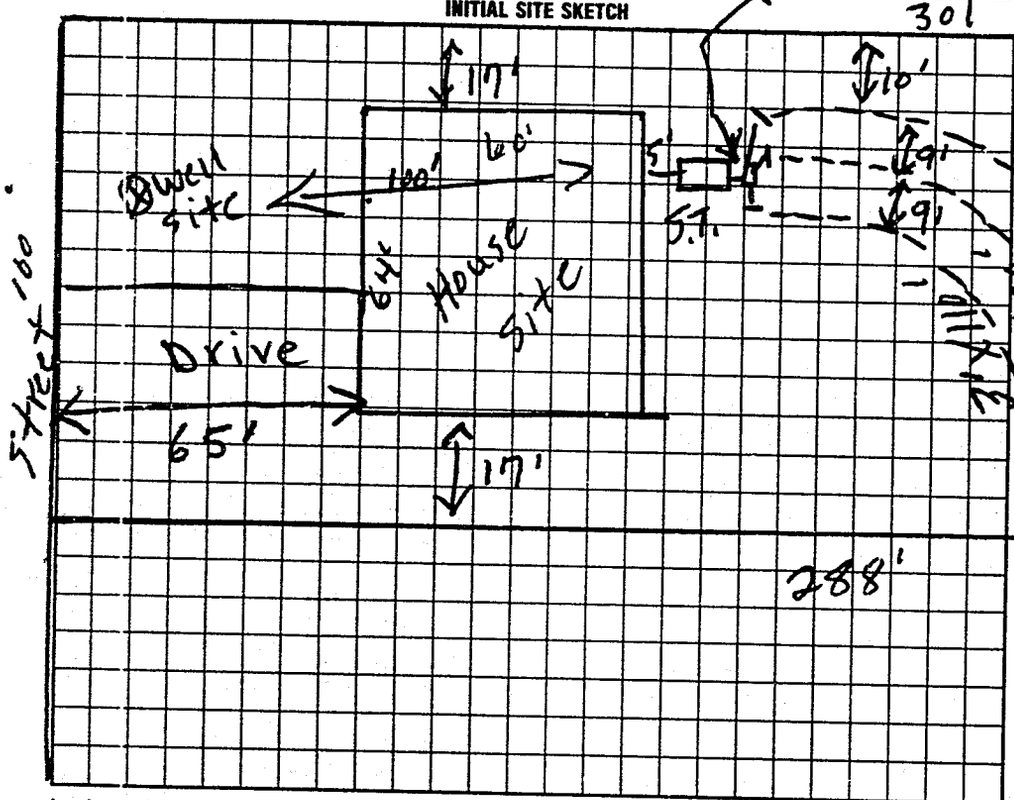

AS BUILT SKETCH

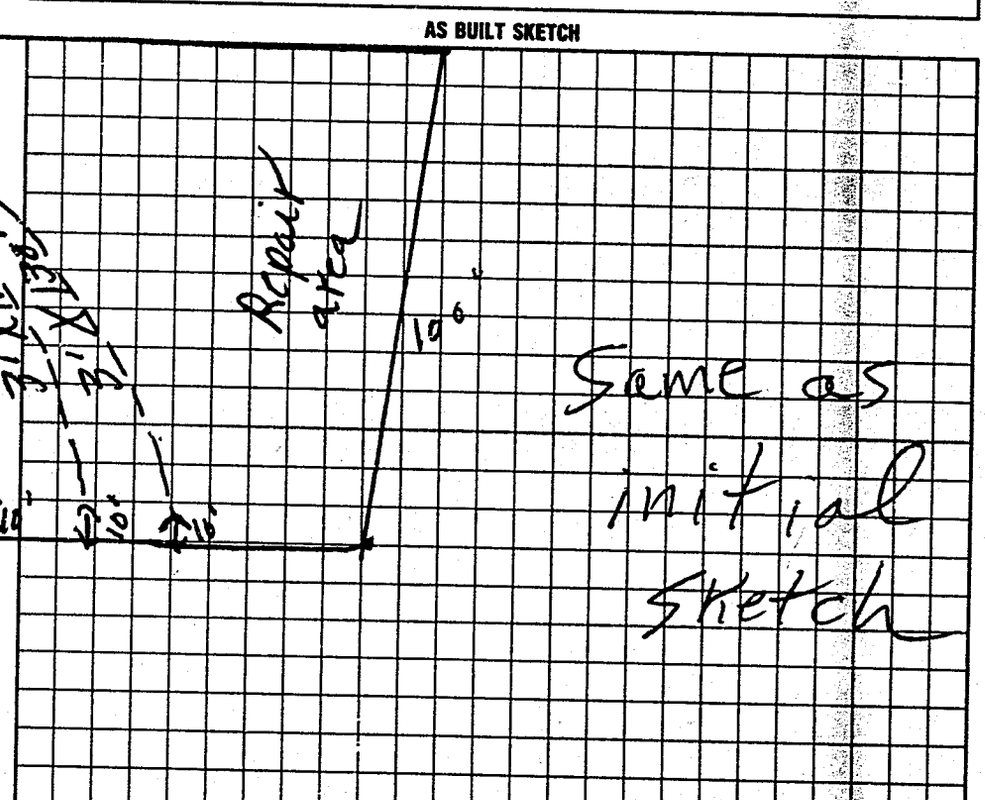

I understand that this permit can be suspended or revoked if any false information is supplied toward securing the permit/any unauthorized changes are made to the site/any unauthorized changes are made in the installation of the system. Improvement Permit is valid for 60 months from date of issuance.

Signed: X Robert B. Hall

Improvement Permit by: E. C. moore date 9-9-97

Existing System Inspection by: E. C. moore date 9-9-97

Authorization to count.

Installed by: Curt Dunning

Certificate of Completion by: date

Operation Permit by: E. C. moore date 12-10-98

HEALTH DEPT. COPY: WHITE INSPECTION COPY (FINAL): GREEN OWNER COPY (FINAL): YELLOW INSPECTION COPY (INITIAL): PINK OWNER COPY (INITIAL): GOLD

Authorization to count EXPIRES 60 mos from issue.