IREDELL COUNTY HEALTH DEPARTMENT

Statesville Phone TR 3-7271 Mooresville Phone NO 3-1271

PERMIT TO INSTALL SEPTIC TANK

Permit No. 182 Permit Date 7-14 1972

Owner Blk. ALLIE Robertson Hal-Murdock Address Troutman NC.

Installed By HARLEE LACKEY Address Stony Point NC.


Location of Property Troutman — Murdock Rd — on Right before Amity Hill Rd.

Tank		Capacity		Length of Lines		Fixtures	
Block	( )	1000	(✓)	225'	( )	No. of Baths	(3)
Precast	(✓)	1250	( )	250'	( )	Dishwasher	(1)
		1500	( )	Other 258		Garbage Grdr.	( )
		Other				Other	

NOTIFY HEALTH DEPARTMENT AT LEAST EIGHT HOURS BEFORE TANK IS TO BE INSPECTED.

Final Inspection 7-14 1972 Approved (✓) Disapproved ( )

Remarks

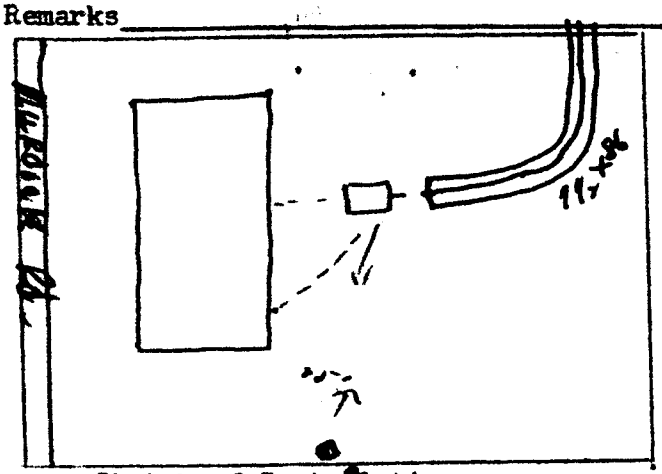

Sketch of Installation

Sanitarian