IREDELL COUNTY HEALTH DEPARTMENT

STATESVILLE 704-878-5305 MOORESVILLE 704-664-5281

IMPROVEMENT PERMIT / AUTHORIZATION TO CONSTRUCT / OPERATION PERMIT / EXISTING SYSTEM INSPECTION

PERMIT# 79432 PIN# 4742650832 DATE 3-25-99

OWNER OR CONTRACTOR Robert Hall PHONE: Business 8380622 Home

ADDRESS 124 Suzuki Dr. Troutman

LOCATION 215 TL Murdock TR Hamilton, .8 mi Rt.

SUBDIVISION Silo acres BLOCK / SECTION LOT 104+105 LOT AREA 1 3/4 acres SITE CLASS PS DESIGN FLOW 360 L.T.A.R. 13

Septic Tank: 1000 Gallons; STB 312 Date 5 22 00
Pump Tank: Gallons; PT Date
Pump Make: Model Serial No.
Nitrification Field: No Fields 1 Square Feet 1200 Linear Feet 400
No Lines 4 Trench Width 36" Max Trench Bottom Depth 36" Gravel Depth 12"

☑ New System ☐ Repair System Type: I ☒ III IV V VI
System Description: Conv. Gravity
Repair System Description:
Maintenance Agreement Required: ☐ Yes ☒ No


☑ House/Mod. Home No. Bedrooms 3
☐ Mobile Home No. Bathrooms 2
☐ Business No. Employees
☐ Other
☐ Slab ☐ Crawl Space ☐ Basement w/plumbing ☑ Basement wo/plumbing

Water Supply: ☑ Individual ☐ Public ☐ Community

Comments/Conditions: 200' Stream

Comments/Conditions: Zabel filter used

INITIAL SITE SKETCH

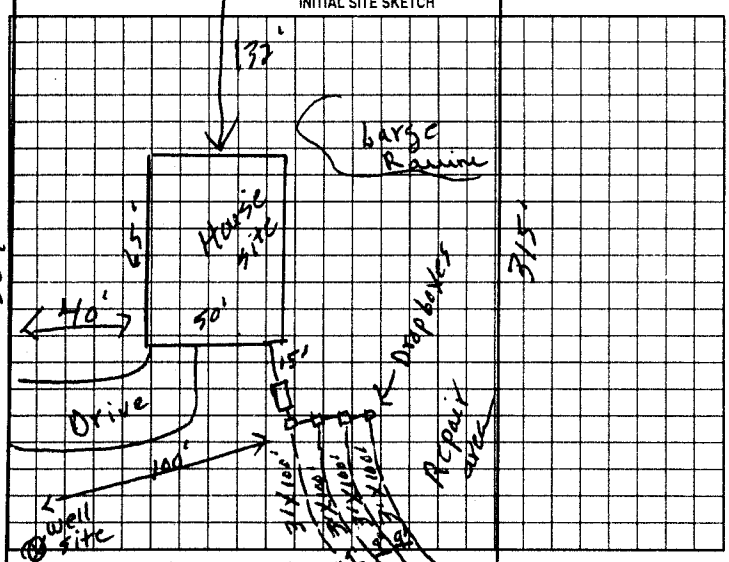

AS BUILT SKETCH

System installed as Designed

Permit can be suspended or revoked if any false information is supplied toward securing the permit/any unauthorized changes are made to the site/any unauthorized changes are made in the installation of the system. Improvement Permit with plat valid without expiration. Improvement Permit without plat valid for sixty months. Authorization to Construct is valid for a period equal to that of Improvement Permit – not to exceed sixty months.

Signed: x Robert Hall date Installed by: Curt Dunning

Improvement Permit by: R.C. Moore date 3-25-99 Operation Permit by: J.C. Potter date June 2 2000

Authorization to Construct by: R.C. Moore date 3-25-99 Existing System Inspection by: date

HEALTH DEPT. COPY WHITE OWNER COPY (FINAL) YELLOW OWNER COPY (INITIAL) PINK