IREDELL COUNTY HEALTH DEPARTMENT

STATESVILLE 704-878-5305 MOORESVILLE 704-664-5281

IMPROVEMENT PERMIT / AUTHORIZATION TO CONSTRUCT / OPERATION PERMIT / EXISTING SYSTEM INSPECTION

PERMIT# 100222 PIN# 4942660486

OWNER OR CONTRACTOR Robert Hall PHONE: Business — Home (704) 838-0622 DATE 5/18/01

ADDRESS 132 Suzuki Drive Statesville NC, 28625

LOCATION I-77 S Exit # 45, Left Byrdock Rd, (R) on Hamilton (R) on Suzuki, 80 to End

SUBDIVISION Silo Acres BLOCK / SECTION — LOT 4 LOT AREA 3.99 SITE CLASS PS DESIGN FLOW 360 L.T.A.R. .22 ps/ft2

Septic Tank: 4000 Gallons, STB 794 Date 4/30/01
Pump Tank: — Gallons, PT — Date —
Pump Make: — Model — Serial No. —
Nitrification Field: No Fields 1 Square Feet 4800 Linear Feet 600'
No Lines 4 & 10 Trench Width 36" Max Trench Bottom Depth 36" Gravel Depth 12"

[X] New System [ ] Repair System Type: I II III IV V VI
System Description: Gravity Conventional
Repair System Description: Pump 50% Reduction
Maintenance Agreement Required: [ ] Yes [ ] No


[X] House/Mod. Home [ ] Mobile Home [ ] Business [ ] Other
No. Bedrooms 3 No. Bathrooms 2 No. Employees —
[ ] Slab [X] Crawl Space [ ] Basement w/plumbing [ ] Basement wo/plumbing

Water Supply: [X] Individual [ ] Public [ ] Community

Comments:/Conditions: ① Install lines on contour ② Keep 50 ft from well ③ Keep 50 ft from Pond ④ Split-feed 4/4 drop boxes

Comments:/Conditions:
- Septic Tank Marker Installed
- Zabel Filter Installed

INITIAL SITE SKETCH (Not To Scale)

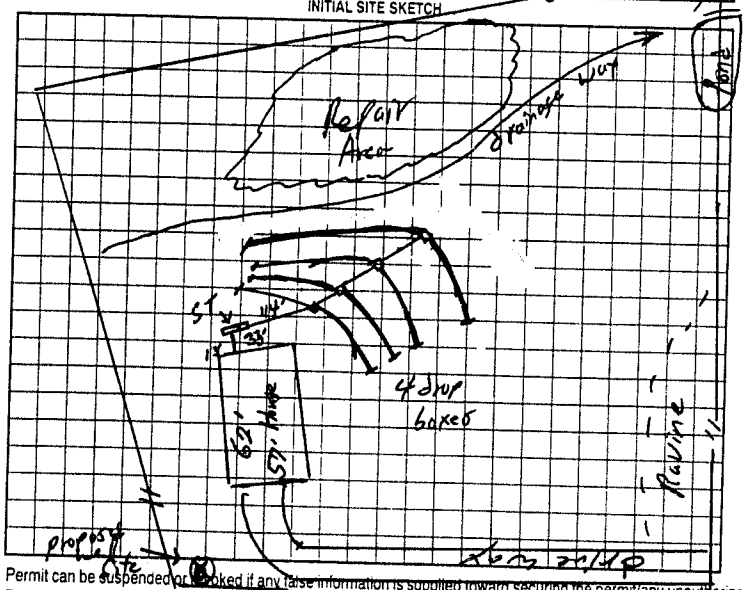

AS BUILT SKETCH

Installed as per Initial Site Sketch

Permit can be suspended or revoked if any false information is supplied toward securing the permit/any unauthorized changes are made to the site/any unauthorized changes are made in the installation of the system. Improvement Permit with plat valid without expiration. Improvement Permit with site plan valid for sixty months. Authorization to Construct is valid for a period equal to that of Improvement Permit – not to exceed sixty months.

Signed: Roberto Hall date 5-30-01

Improvement Permit by: William O. Johnson date 5/18/01

Authorization to Construct by: William O. Johnson date 5/19/01

Installed by: Curt Dunning

Operation Permit by: William O. Johnson date 6/12/01

Existing System Inspection by: — date —

HEALTH DEPT. COPY: WHITE OWNER COPY (FINAL) YELLOW OWNER COPY (INITIAL) PINK