ICHD - ENVIRONMENTAL HEALTH DIVISION

Statesville Office (704) 878-5305 Mooresville Office (704) 660-3625 PERMIT # 2023-14292

SEPTIC: IMPROVEMENT PERMIT / AUTHORIZATION TO CONSTRUCT / OPERATION PERMIT / EXISTING SYSTEM Repair PIN # 4742 -- 64 -- 8539

APPLICANT/OWNER: Amy Sheets APPLICANT ADDRESS: ~~2589~~ Amity Hill Rd, Statesville, NC 28677

SITE ADDRESS: 2589 Amity Hill Rd, Statesville, NC 28677 PHONE: (704) 506-1597 ALT. PHONE —

SITE DIRECTIONS: N Center St, (L) Amity Hill SAP CONTROLLED: ☐ YES ☐ NO

SUBDIVISION: — SECTION: — LOT # 1 LOT AREA: .98Ac DESIGN FLOW: Ext L.T.A.R.: Ext


Septic Tank	1000	(gal)	STB	750	Date	6/7/23	☐ New System ☑ Repair ☐ Expansion	System Type: I II III IV V VI	
Pump Tank		(gal)	PT		Date		System Description:		
Pump Make			Model		Serial #		Repair System Description:	Tank Replacement	
# Nitrification Fields	Ext	# Lines	Ext		Linear Ft	Ext	Maintenance Agreement Required:	☐ YES ☑ NO	
Trench Width	Ext	Trench Bottom Depth(Low side)		Ext	Gravel Depth	Ext	☑ GRAVITY ☐ PRESSURE		

☑ Residence No. Bedrooms Ext
☐ Business No. Persons Ext
☐ Other No. Employees
☐ Slab ☑ Crawl Space
☐ Basement w/plumbing ☐ Basement w/o plumbing

Water Supply: ☑ Private ☐ Public ☐ Community

Comments / Conditions: Pump, crush, fill old tank, place new tank where taper fall can be achieved, Stay 50ft off well. Neighbor well is close in backyard.

INITIAL SITE SKETCH

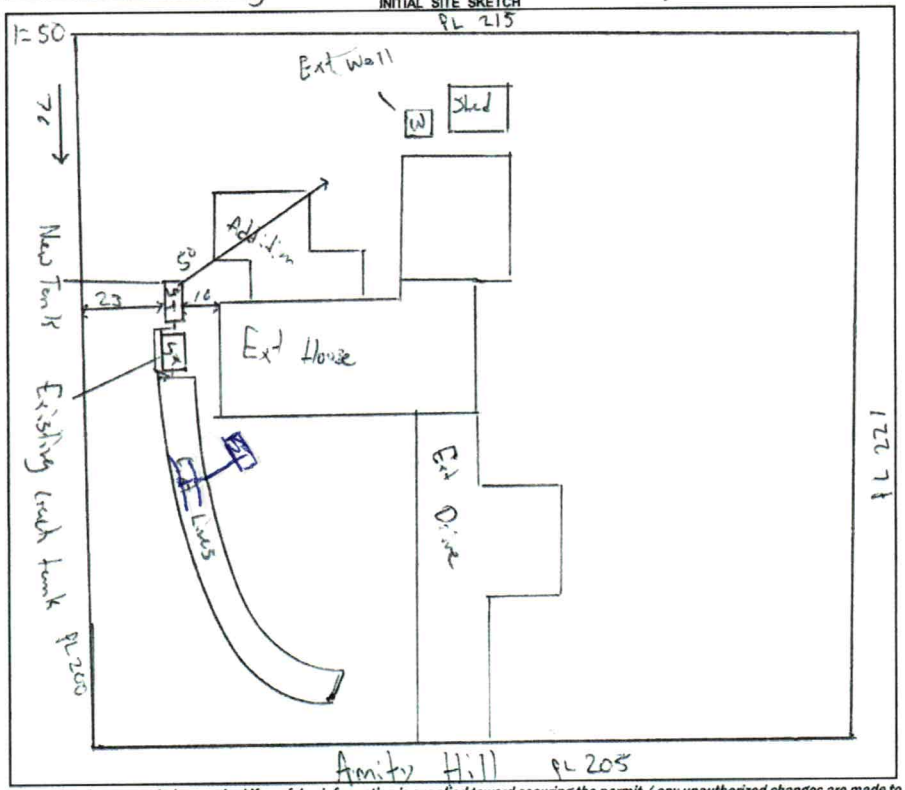

AS BUILT SKETCH

FOR SEPTIC FINAL INSPECTION CALL: 704-664-3703 between 8am-9am the day the inspection is needed. Be sure to speak with an inspector to confirm your time.

Permit can be suspended or revoked if any false information is supplied toward securing the permit / any unauthorized changes are made to the site / any unauthorized changes are made in the installation of the system. **CONTACT A LOCATOR SERVICE PRIOR TO ANY EXCAVATION**

☐ **IMPROVEMENT PERMIT** *with plat valid without expiration.* ☑ **IMPROVEMENT PERMIT** *with site plan valid for 60 mos.* ☑ **AUTHORIZATION TO CONSTRUCT** *valid for period equal to IMPROVEMENT PERMIT--not to exceed 60 mo.*

Owner / Applicant Signature: Online Signature Date: — Installed by: Lentz Wastewater

IMPROVEMENT PERMIT by: Martha Winn Date: 4/26/23 OPERATION PERMIT by: D. Meberg Date: 7/24/23

AUTHORIZATION TO CONSTRUCT by: Martha Winn Date: 4/26/23 Existing System Inspected by: — Date: —

FOR SEPTIC FINAL INSPECTION: CALL 704-664-3703 between 8am-9am the day the inspection is needed.

ICHD - ENVIRONMENTAL HEALTH DIVISION

Statesville Office (704) 878-5305 Mooresville Office (704) 660-3625 PERMIT # 2023-19292

SEPTIC: IMPROVEMENT PERMIT / AUTHORIZATION TO CONSTRUCT / OPERATION PERMIT / EXISTING SYSTEM

PIN # 4742 -- 64 -- 8539

APPLICANT/OWNER: Amy Sleets APPLICANT ADDRESS: 2589 Amity Hill Rd, Statesville, NC 28677

SITE ADDRESS: 2589 Amity Hill Rd, Statesville, NC 28677 PHONE: (704) 506-1557 ALT. PHONE —

SITE DIRECTIONS: N Center St, L Amity Hill SAP CONTROLLED: ☐ YES ☐ NO

SUBDIVISION: — SECTION: — LOT # 1 LOT AREA: .98AC DESIGN FLOW: Ext L.T.A.R.: Ext

Septic Tank	1000	(gal)	STB		Date						
Pump Tank		(gal)	PT		Date						
Pump Make		Model			Serial #						
# Nitrification Fields	Ext	# Lines	Ext		Linear Ft	Ext					
Trench Width	Ext	Trench Bottom Depth(Low side)		Ext	Gravel Depth	Ext					

☐ New System ☑ Repair ☐ Expansion System Type: I II III IV V VI

System Description: —

Repair System Description: Tank Replacement

Maintenance Agreement Required: ☐ YES ☑ NO

☑ GRAVITY ☐ PRESSURE

☑ Residence No. Bedrooms Ext

☐ Business No. Persons Ext

☐ Other No. Employees

☐ Slab ☑ Crawl Space

☐ Basement w/plumbing ☐ Basement w/o plumbing

Water Supply


☑ Private

☐ Public

☐ Community

Comments / Conditions: Pump, crush, fill old tank. Place new tank where proper fall can be achieved. Stay 50ft off well. Neighbor well is also in backyard.

INITIAL SITE SKETCH

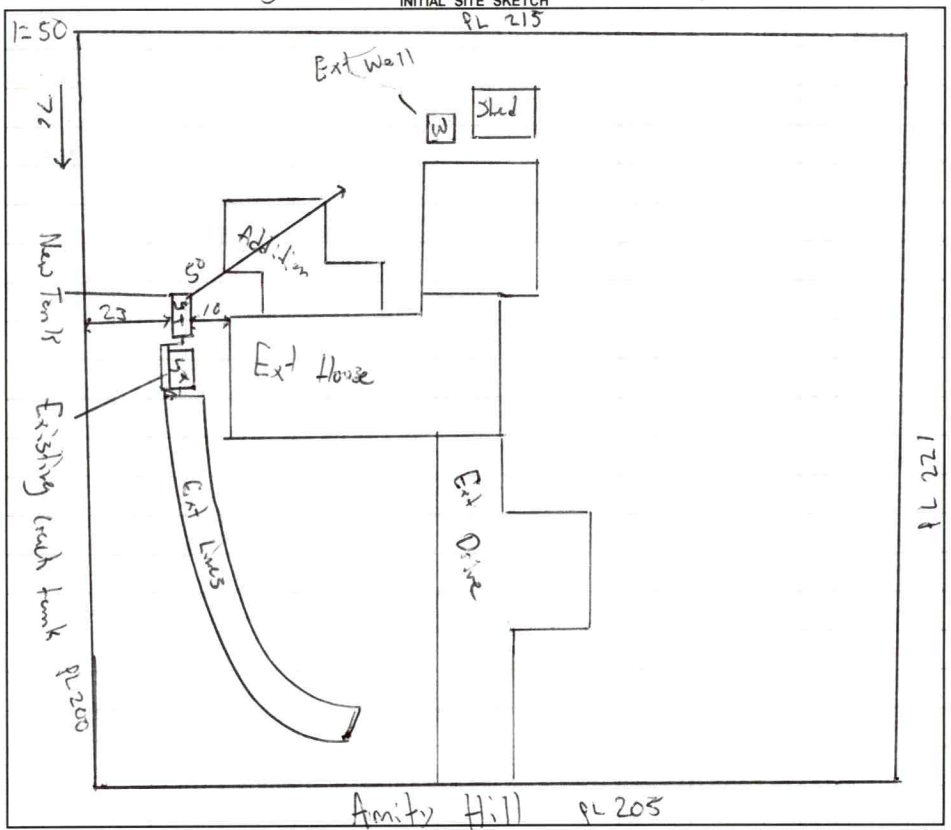

AS BUILT SKETCH

FOR SEPTIC FINAL INSPECTION CALL: 704-664-3703 between 8am-9am

the day the inspection is needed. Be sure to speak with an inspector to confirm your time.

Permit can be suspended or revoked if any false information is supplied toward securing the permit / any unauthorized changes are made to the site / any unauthorized changes are made in the installation of the system. **CONTACT A LOCATOR SERVICE PRIOR TO ANY EXCAVATION**

☐ **IMPROVEMENT PERMIT** ***with plat*** *valid without expiration.* ☑ **IMPROVEMENT PERMIT** ***with site plan*** *valid for 60 mos.* ☑ **AUTHORIZATION TO CONSTRUCT** *valid for period equal to IMPROVEMENT PERMIT--not to exceed 60 mo.*

Owner / Applicant Signature: Online Signature Date: — Installed by: —


IMPROVEMENT PERMIT by: Matthew Winn Date: 4/26/23 OPERATION PERMIT by: — Date: —

AUTHORIZATION TO CONSTRUCT by: Matthew Winn Date: 4/26/23 Existing System Inspected by: — Date: —

FOR SEPTIC FINAL INSPECTION: CALL 704-664-3703 between 8am-9am the day the inspection is needed.

Item	Date	Initials
Drain Lines Checked		
Tanks Checked		
Pressure Manifold or Valve Box Checked		
Pressure Head Set		
Electrical Checked		
Floats Set		
Alarm Checked		
Maintenance Contract Needed? Y / N		
Comments:		

Repairs Only	
	State Code
Failing System Code	
Type of Distribution	G or P
Type of Failure/Malfunction	
Primary Cause of Failure/Malfunction	
Age of System? _____	
Initial or Repair? _____	

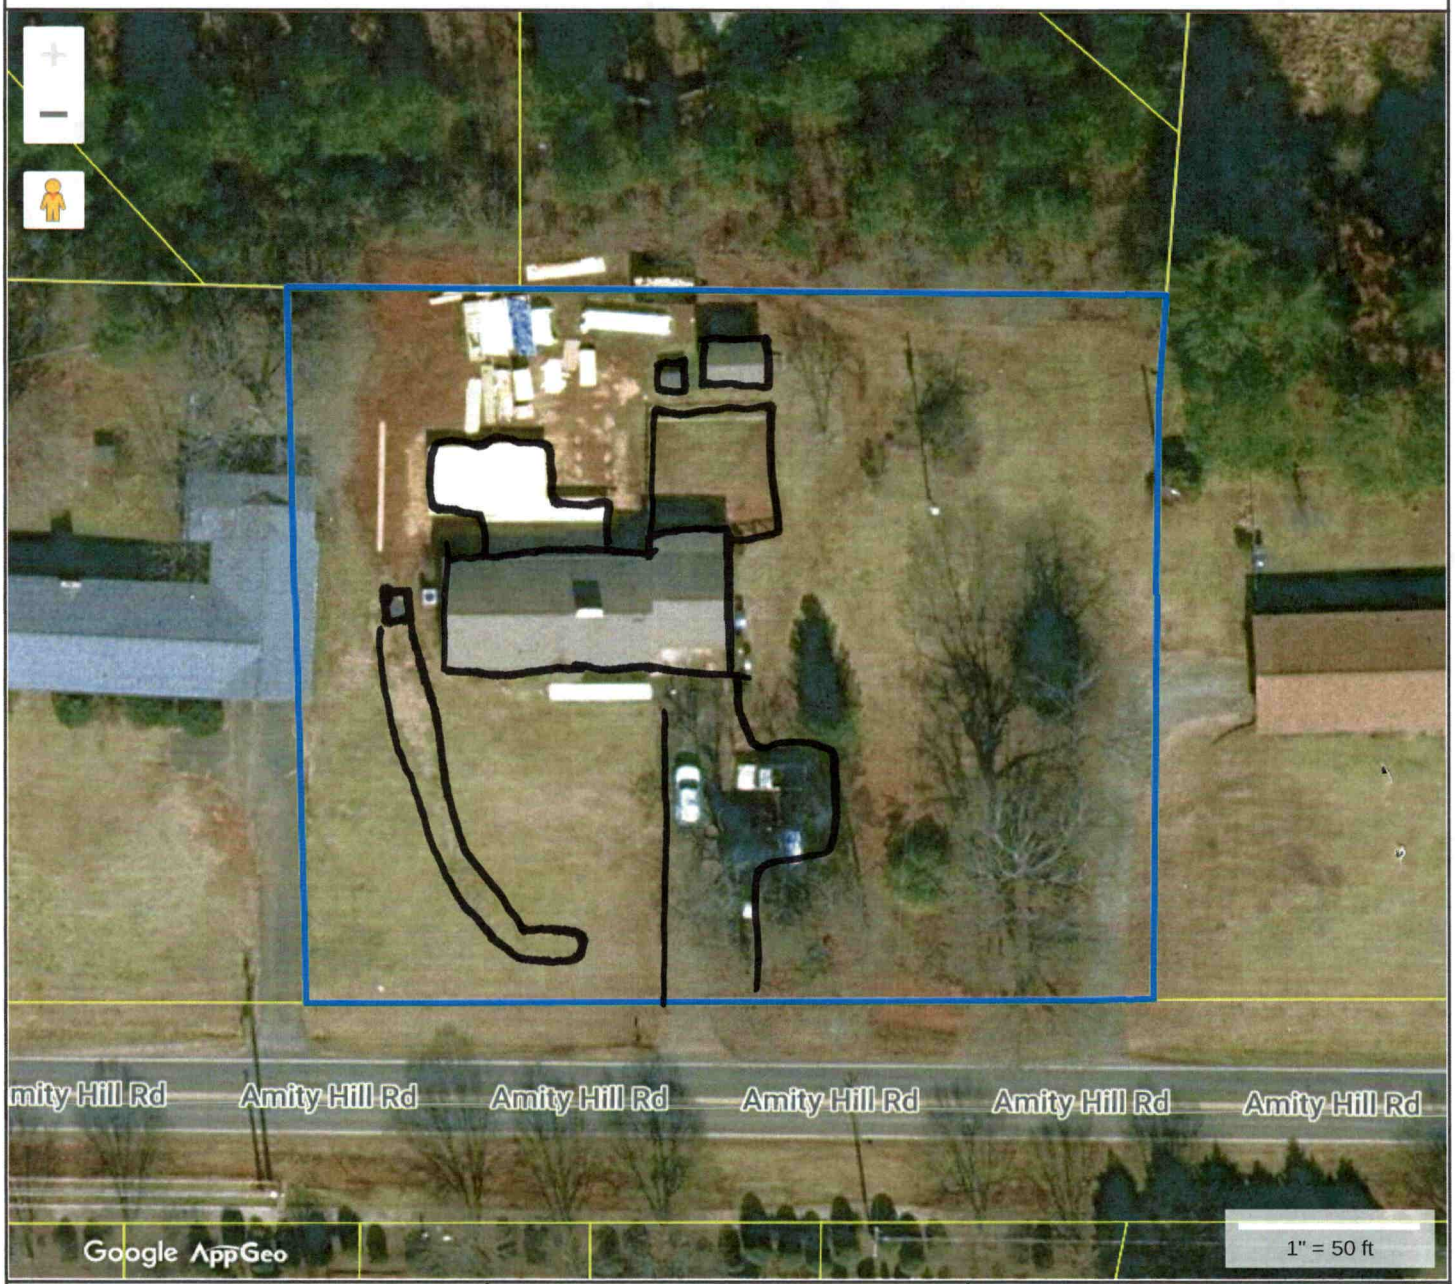

Tax Map Information

• PIN	4742698539.000
• Address	2589 AMITY HILL RD
• Account #	Acct 80091773
• Tax Owner	SHEETS JASON EDWARD
• Mailing Address	2589 AMITY HILL RD
•	STATESVILLE, NC 28677
• GIS Owner	SHEETS JASON E+AMY J ULSH
• Deed Info	2912 / 878 - QC - 20220418
• Tax Acres	0.98 AC
• Lot #	
• Description	N SIDE AMITY HILL RD SR2342
• Zoning	RA
• Old Parcel #	0206A00000A008
• Bldg Value	$317,250
• OBXF Value	$3,350
• Land Value	$44,100
• Total Value	$364,700
• Defer Value	$0
• Tax Districts	-ALLCNTY FIRE- -


IREDELL COUNTY NC

MAP FOR REFERENCE ONLY
NOT A LEGAL DOCUMENT

Iredell County, North Carolina makes no claims and no warranties, expressed or implied, concerning the validity or accuracy of the GIS data presented on this map.

Geometry updated 04/18/2023
Data updated 04/18/2023

Print map scale is approximate. Critical layout or measurement activities should not be done using this resource.

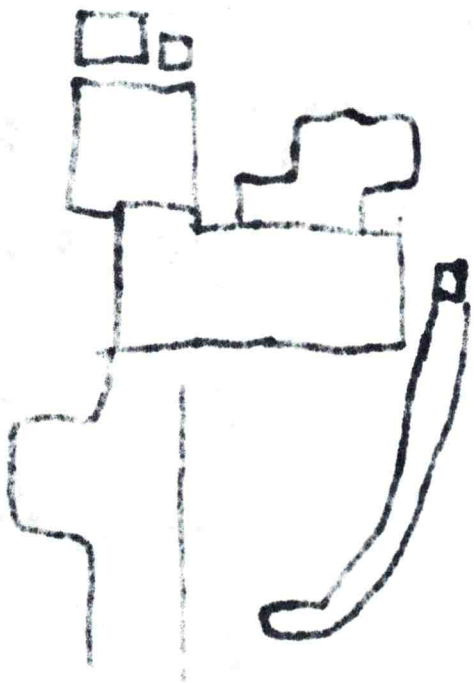


IREDELL COUNTY HEALTH DEPARTMENT

ENVIRONMENTAL HEALTH DIVISION

PAGE 2: *SITE PLAN WORKSHEET*

SEE THE "SAMPLE SITE PLAN" BELOW. INCOMPLETE SITE PLANS WILL BE RETURNED TO YOU FOR COMPLETION AND MAY RESULT IN A DELAY IN THE ISSUANCE OF YOUR SEPTIC SYSTEM PERMIT!!!

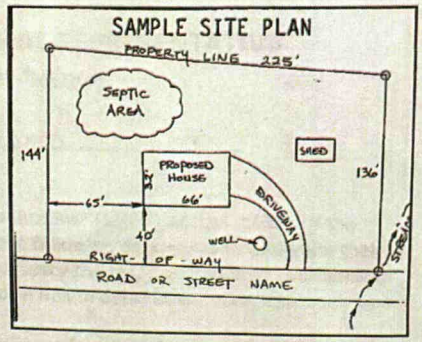

Place an (X) beside each item as you complete the site plan:


- (X) Property Line measurements are clearly identified
- (X) All proposed structures are indicated
- ( ) Front and side setbacks from property line
- (X) Preferred driveway location and well location
- (X) Area you prefer your septic system to be placed
- (X) North arrow, or other sufficient indicator of direction

Circle N/A on the following if appropriate:

Location of septic systems and wells within 100' of your property	N/A
Location of easements and rights of ways on your property	N/A
Location of any designated wetlands on the property	N/A

USE THIS SPACE TO DRAW YOUR SITE PLAN

Show: proposed house or business footprint, wells, water lines, patios, pools and decks, and any other item that will occupy space on the site

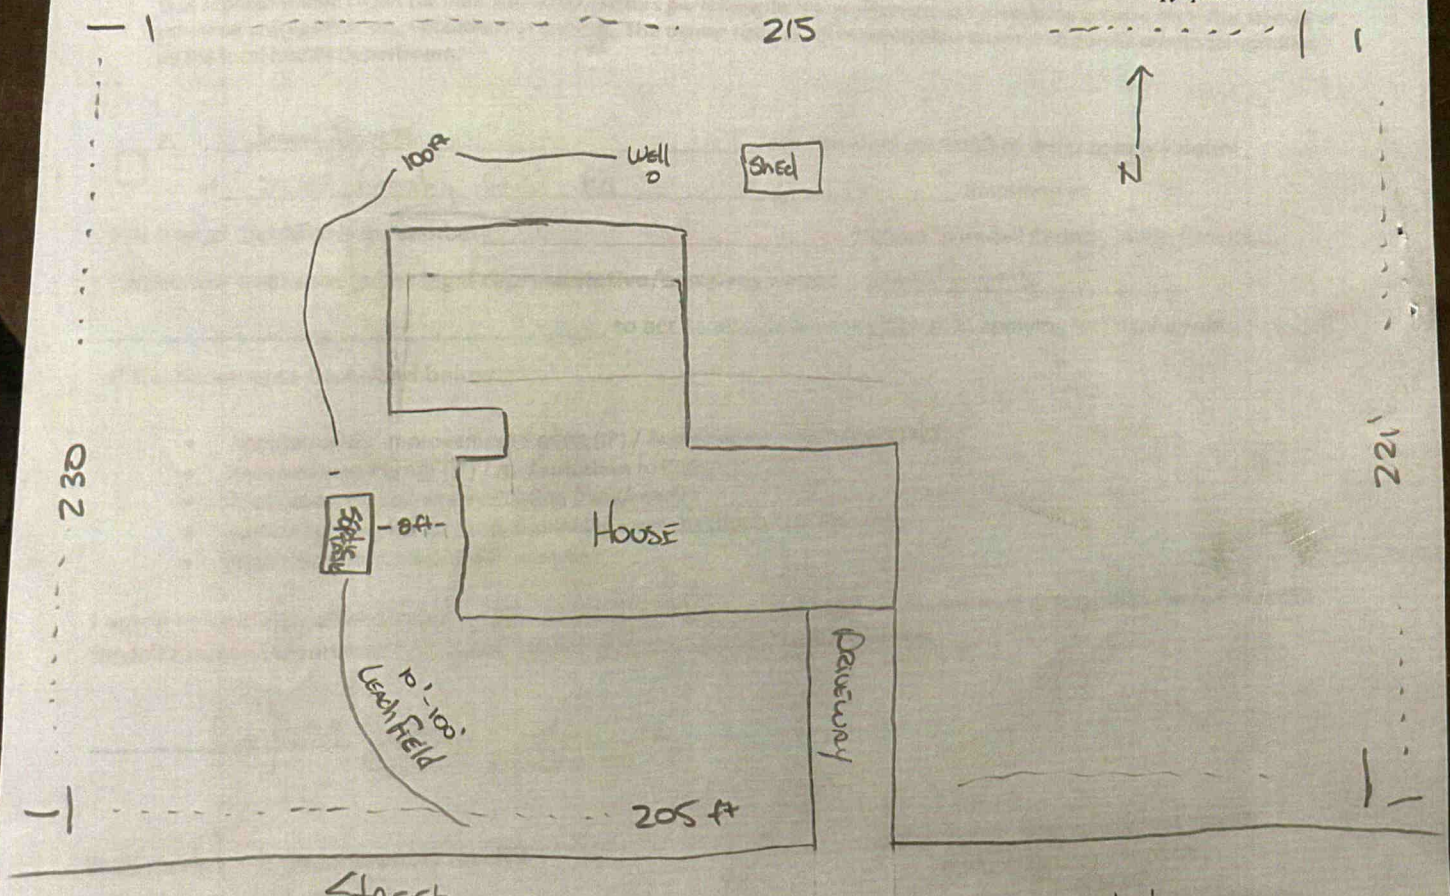

Signature: Jason Fuentes
Property owner or owner's legal representative signature (SIGNATURE REQUIRED)

2/19/23
DATE