ICHD - ENVIRONMENTAL HEALTH DIVISION

Statesville Office (704) 878-5305 | Mooresville Office (704) 660-3625 | PERMIT # OSWP 2023-28230

SEPTIC: IMPROVEMENT PERMIT / AUTHORIZATION TO CONSTRUCT / OPERATION PERMIT / EXISTING SYSTEM Repair

PIN # 4742 -- 75 -- 3671

APPLICANT/OWNER: Jeanie Lentz | APPLICANT ADDRESS: 463 Lentz Rd, Statesville 28625

SITE ADDRESS: 703 Murdock Rd, Troutman 28166 | PHONE: 980-829-3278 | ALT. PHONE 704-876-9299

SITE DIRECTIONS: Amity Hill - (R) Murdock - Lot on (R) | SAP CONTROLLED: ☐ YES ☐ NO

SUBDIVISION: | SECTION: — | LOT #: — | LOT AREA: 1.72 | DESIGN FLOW: Ex | L.T.A.R.: Ex


Septic Tank	1000 (gal)	STB	760	Date	5/7/23	☐ New System	☑ Repair	☐ Expansion	System Type: I (II) III IV V VI
Pump Tank	(gal)	PT		Date		System Description:			
Pump Make		Model		Serial #		Repair System Description:	Tank Replacement		
# Nitrification Fields	Ex	# Lines	Ex	Linear Ft	Ex	Maintenance Agreement Required:	☐ ~~YES~~	☐ ~~NO~~	
Trench Width	Ex	Trench Bottom Depth(Low side)	Ex	Gravel Depth	Ex		☐ ~~GRAVITY~~	☐ ~~PRESSURE~~	

☑ Residence	No. Bedrooms	Ex	**Water Supply**
☐ Business	No. Persons	Ex	☑ Private
☐ Other	No. Employees		☐ Public
☐ Slab	☐ Crawl Space		☐ Community
☐ Basement w/plumbing			☑ Basement w/o plumbing

Comments / Conditions: Pump, crush, fill old tank. Keep 15' off foundation & 50' off well. Replace distribution if necessary.

INITIAL SITE SKETCH

1=60

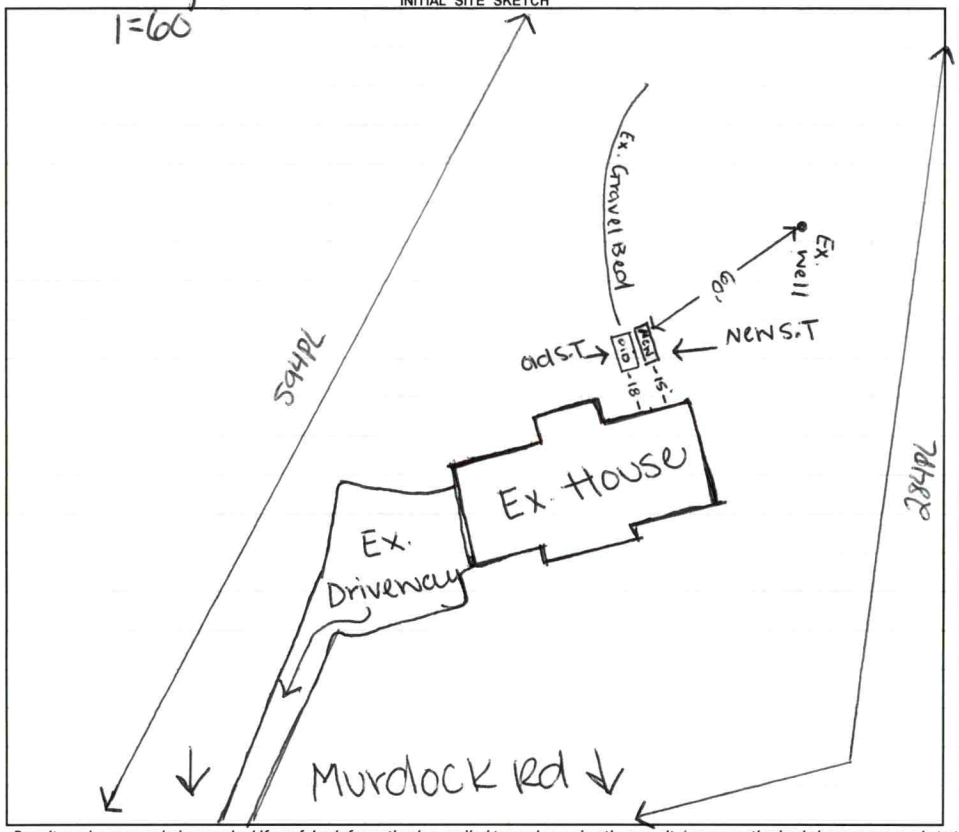

AS BUILT SKETCH

FOR SEPTIC FINAL INSPECTION CALL: 704-664-3703 between 8am-9am the day the inspection is needed. Be sure to speak with an inspector to confirm your time.

Installed as Drawn

Permit can be suspended or revoked if any false information is supplied toward securing the permit / any unauthorized changes are made to the site / any unauthorized changes are made in the installation of the system. **CONTACT A LOCATOR SERVICE PRIOR TO ANY EXCAVATION**

☐ **IMPROVEMENT PERMIT** *with plat* valid without expiration. ☑ **IMPROVEMENT PERMIT** *with site plan* valid for 60 mos. ☑ **AUTHORIZATION TO CONSTRUCT** valid for period equal to IMPROVEMENT PERMIT--not to exceed 60 mo.

Owner / Applicant Signature: online | Date: — | Installed by: Lentz

IMPROVEMENT PERMIT by: Sydney Holland | Date: 6/20/23 | OPERATION PERMIT by: Cary Hill | Date: 7/17/23

AUTHORIZATION TO CONSTRUCT by: Sydney Holland | Date: 6/20/23 | Existing System Inspected by: | Date:

FOR SEPTIC FINAL INSPECTION: CALL 704-664-3703 between 8am-9am the day the inspection is needed.

Item	Date	Initials
Drain Lines Checked		
Tanks Checked		
Pressure Manifold or Valve Box Checked		
Pressure Head Set		
Electrical Checked		
Floats Set		
Alarm Checked		
Maintenance Contract Needed? Y / N		
Comments:		

Repairs Only	
	State Code
Failing System Code	
Type of Distribution	G or P
Type of Failure/Malfunction	
Primary Cause of Failure/Malfunction	
Age of System? _____	
Initial or Repair? _____	



Tax Map Information

• PIN	4742753671.000
• Address	703 MURDOCK RD
• Account #	Acct 80097704
• Tax Owner	CASH ANGINETTE H
• Mailing Address	703 MURDOCK RD
•	TROUTMAN, NC 28166
• GIS Owner	CASH ANGINETTE H
• Deed Info	408 / 14 - DD - 20221205
• Tax Acres	1.72 AC
• Lot #	
• Description	CASH SR2350
• Zoning	RA
• Old Parcel #	0206A00000A031
• Bldg Value	$184,840
• OBXF Value	$3,250
• Land Value	$63,730
• Total Value	$251,820
• Defer Value	$0
• Tax Districts	-ALLCNTY FIRE- -

IREDELL COUNTY NC

MAP FOR REFERENCE ONLY
NOT A LEGAL DOCUMENT

Iredell County, North Carolina makes no claims and no warranties, expressed or implied, concerning the validity or accuracy of the GIS data presented on this map.

Geometry updated 06/05/2023
Data updated 06/05/2023

Print map scale is approximate. Critical layout or measurement activities should not be done using this resource.