ICHD - ENVIRONMENTAL HEALTH DIVISION

Statesville Office (704) 878-5305 MW Mooresville Office (704) 660-3625

PERMIT # AP 2022-2923

SEPTIC: IMPROVEMENT PERMIT / AUTHORIZATION TO CONSTRUCT / OPERATION PERMIT / EXISTING SYSTEM

PIN # 4742 -- 79 -- 2242

APPLICANT/OWNER: Joanne Green APPLICANT ADDRESS: 229 Shepherds Bluff Dr, Mooresville

SITE ADDRESS: 2610 Amity Hill Rd, Statesville 28677 PHONE: 702-690-5312 ALT. PHONE

SITE DIRECTIONS: 115 S - Amity Hill SAP CONTROLLED: ☐ YES ☐ NO

SUBDIVISION: - SECTION: - LOT # - LOT AREA: 1.109 acres DESIGN FLOW: 240 gpd L.T.A.R.: 0.3

Septic Tank 1000 (gal) STB 1012 Date 9/11/22
Pump Tank (gal) PT Date
Pump Make Model Serial #
Nitrification Fields 1 # Lines 2 Linear Ft 200'
Trench Width 36" Trench Bottom Depth(~~Low side~~) 36" max Gravel Depth -


☐ New System ☒ Repair ☐ Expansion System Type: I II (III) IV V VI
System Description: 25% reduction
Repair System Description:
Maintenance Agreement Required: ☐ YES ☒ NO
☒ GRAVITY ☐ PRESSURE

☒ Residence No. Bedrooms 2
☐ Business No. Persons 4
☐ Other No. Employees
☐ Slab ☒ Crawl Space
☐ Basement w/plumbing ☐ Basement w/o plumbing

Water Supply: ☒ Private ☐ Public ☐ Community

Comments / Conditions: Pump, crush, & fill old septic tank. Install lines on contour with the land. Utilize serial distribution. Keep 50' from existing well under house.

INITIAL SITE SKETCH

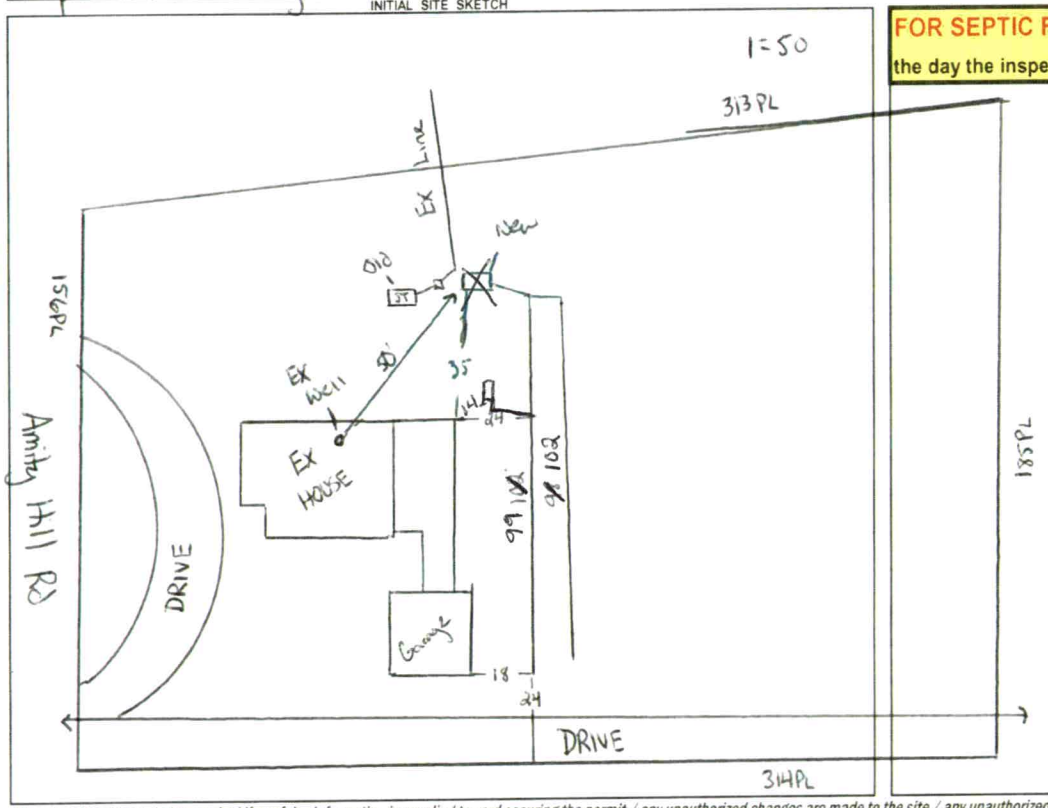

AS BUILT SKETCH

Installed as Drawn

FOR SEPTIC FINAL INSPECTION CALL: 704-664-3703 between 8am-9am the day the inspection is needed. Be sure to speak with an inspector to confirm your time.

Permit can be suspended or revoked if any false information is supplied toward securing the permit / any unauthorized changes are made to the site / any unauthorized changes are made in the installation of the system. **CONTACT A LOCATOR SERVICE PRIOR TO ANY EXCAVATION**

☐ **IMPROVEMENT PERMIT** ***with plat*** *valid without expiration.* ☒ **IMPROVEMENT PERMIT** ***with site plan*** *valid for 60 mos.* ☒ **AUTHORIZATION TO CONSTRUCT** *valid for period equal to IMPROVEMENT PERMIT--not to exceed 60 mo.*

Owner / Applicant Signature: Online Signature Date:
IMPROVEMENT PERMIT by: Cory Hill Date: 11/2/22
AUTHORIZATION TO CONSTRUCT by: Cory Hill Date: 11/2/22

Installed by: AJ Backhoe
OPERATION PERMIT by: Cory Hill Date: 11/9/22
Existing System Inspected by: Date:

FOR SEPTIC FINAL INSPECTION: CALL 704-664-3703 between 8am-9am the day the inspection is needed.