4742-84-0471.2876

55740

IREDELL COUNTY HEALTH DEPARTMENT

STATESVILLE 704-878-5305 MOORESVILLE 704-664-5281

IMPROVEMENT PERMIT / CERTIFICATE OF COMPLETION / OPERATION PERMIT / EXISTING SYSTEM INSPECTION

PROPERTY DESCRIPTION NO. 20882 DATE 4-25-95 TAX MAP NO. 40-A-22 Watershed: ☐ Yes ☑ No

OWNER OR CONTRACTOR Welling Inc PHONE: Business 878 2577 Home

ADDRESS 28788 Amity Hill Rd

LOCATION I-77 South At Amity Hill Rd Exit

SUBDIVISION 1000 g grease trap BLOCK / SECTION LOT LOT AREA SITE CLASS. DESIGN FLOW 960 L.T.A.R. .132

Septic Tank: 1500 Gallons; STB 7977 Date 3-10-95

Pump Tank: 1500 Gallons; PT 7977PT Date 4-25-95

Pump Make: Goulds Model 3885 Serial No. WE05HH

Nitrification Field: No Fields 1 Square Feet 3000 Linear Feet 1000

No Lines 10 Trench Width 36" Max Trench Bottom Depth 36" Gravel Depth 12"

☑ New System ☐ Repair System Type: I, II, III, IV, V, VI

System Description: Pump To conv. lines

Repair System Description: " " " "

Maintenance Agreement Required: ☐ Yes ☐ No

☐ House/Mod. Home No. Bedrooms

☐ Mobile Home No. Bathrooms

☐ Business No. Employees

☑ Other 24 Seat Restaurant

☑ Slab ☐ Crawl Space ☐ Basement w/plumbing ☐ Basement wo/plumbing


Water Supply: ☑ Individual ☐ Community ☐ Public

Comments: See Attached Drawings for Pump Tank set up & Pressure manifold set up which are part of this Permit

Comments: Brittany's BBQ

Repair Area

INITIAL SITE SKETCH

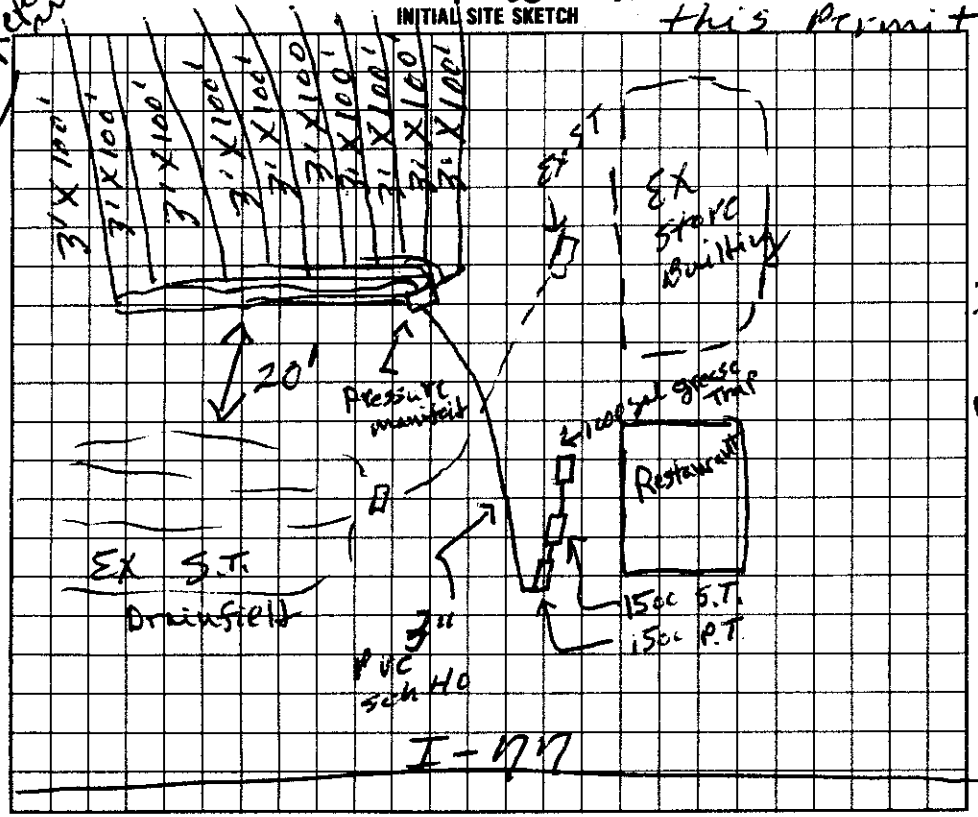

Amity Hill Rd

AS BUILT SKETCH

I understand that this permit can be suspended or revoked if any false information is supplied toward securing the permit/any unauthorized changes are made to the site/any unauthorized changes are made in the installation of the system. Improvement Permit is valid for 60 months from date of issuance.

Signed: [redacted] Charles M Welling

Improvement Permit by: R. C. Moore date 4-25-95

Existing System Inspection by: date

Installed by: James Hutler

Certificate of Completion by: R. C. Moore date 7-20-95

Operation Permit by: date

HEALTH DEPT. COPY: WHITE INSPECTION COPY (FINAL): GREEN OWNER COPY (FINAL): YELLOW INSPECTION COPY (INITIAL): PINK OWNER COPY (INITIAL): GOLD