IREDELL COUNTY HEALTH DEPARTMENT

IF THIS PERMIT REPLACES PREVIOUS ISSUED 5-5-05

STATESVILLE 704-878-5305 MOORESVILLE 704-664-5281

IMPROVEMENT PERMIT / AUTHORIZATION TO CONSTRUCT / OPERATION PERMIT / EXISTING SYSTEM INSPECTION

PERMIT# 126911 PIN# 4742-85-0999 DATE 3-28-06

OWNER OR CONTRACTOR KRISTIE BANNISTER / KPAC PHONE: Business 704-506-2801 Home 704-528-1601

ADDRESS P.O. BOX 4501 MOORESVILLE NC 28117

LOCATION I-77 SOUTH, TR AMITY HILL ROAD, LOT ON RIGHT JUST PAST MURDOCK ROAD AT # 2809

SUBDIVISION ____ BLOCK / SECTION ____ LOT ____ LOT AREA 1.91 ACRES SITE CLASS. PS DESIGN FLOW 550 L.T.A.R. 0.30 GPD/FT²

Septic Tank: 1500 Gallons; STB 357 Date 8-17-07

Pump Tank: ____ Gallons; PT ____ Date ____

Pump Make: ____ Model ____ Serial No. ____

Nitrification Field: No Fields 1 Square Feet 1833 Linear Feet 460

No Lines FIVE Trench Width 36" Max Trench Bottom Depth 30" Gravel Depth N/A

☑ New System ☐ Repair System Type: I, II, III, IV, V, VI

System Description: 25% REDUCTION GRAVITY

Repair System Description: 25% REDUCTION, GRAVITY

Maintenance Agreement Required: ☐ Yes ☑ No

☐ House/Mod. Home No. Bedrooms ____

☐ Mobile Home No. Bathrooms ____

☑ Business No. Employees 8

☐ Other GYM - W/70 STUDENTS @ 5 GPD

☐ Slab ☐ Crawl Space ☐ Basement w/plumbing ☐ Basement wo/plumbing

Water Supply: ☑ Individual ☐ Public ☐ Community

WELL


Comments:/Conditions: ① SMOOTH AREA OVER DRAINFIELD TO ACHIEVE UNIFORM SLOPE ② INSTALL 25% REDUCTION SYSTEM ON CONTOUR AS SHOWN ③ NO FILL MATERIAL ALLOWED OVER DRAINFIELD

Comments:/Conditions:


72 / 80 / 88 / 100 / 170

V.D. LINES & TANK, NEED OWNER TO VERIFY P/L & NEW DROP BOXES V.D

INITIAL SITE SKETCH

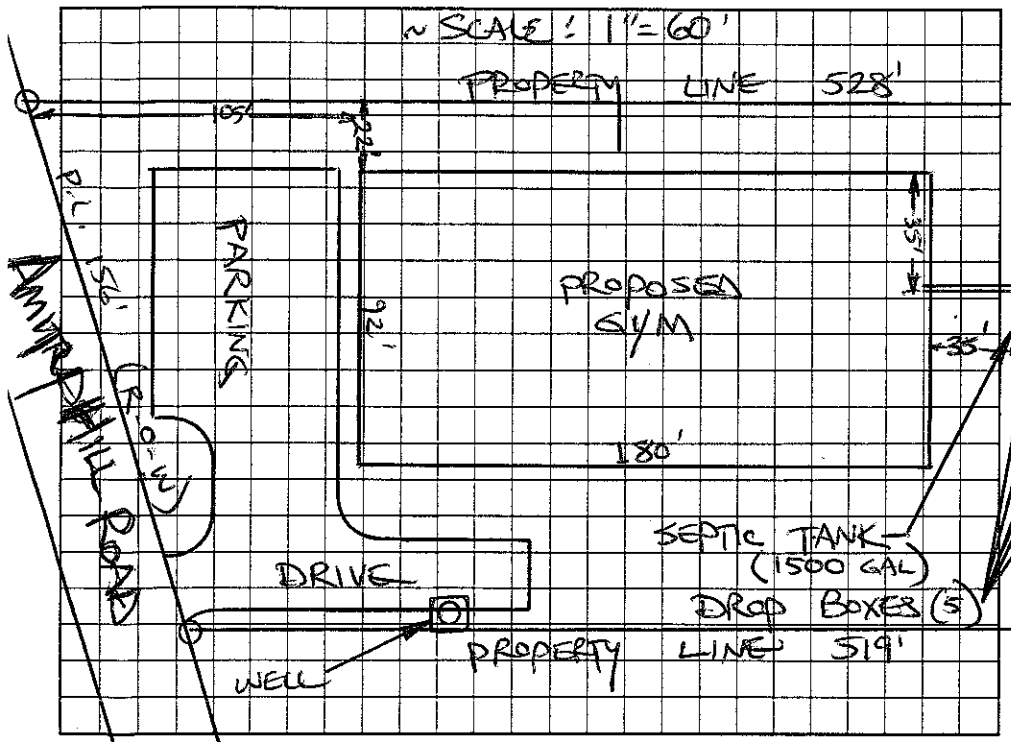

AS BUILT SKETCH

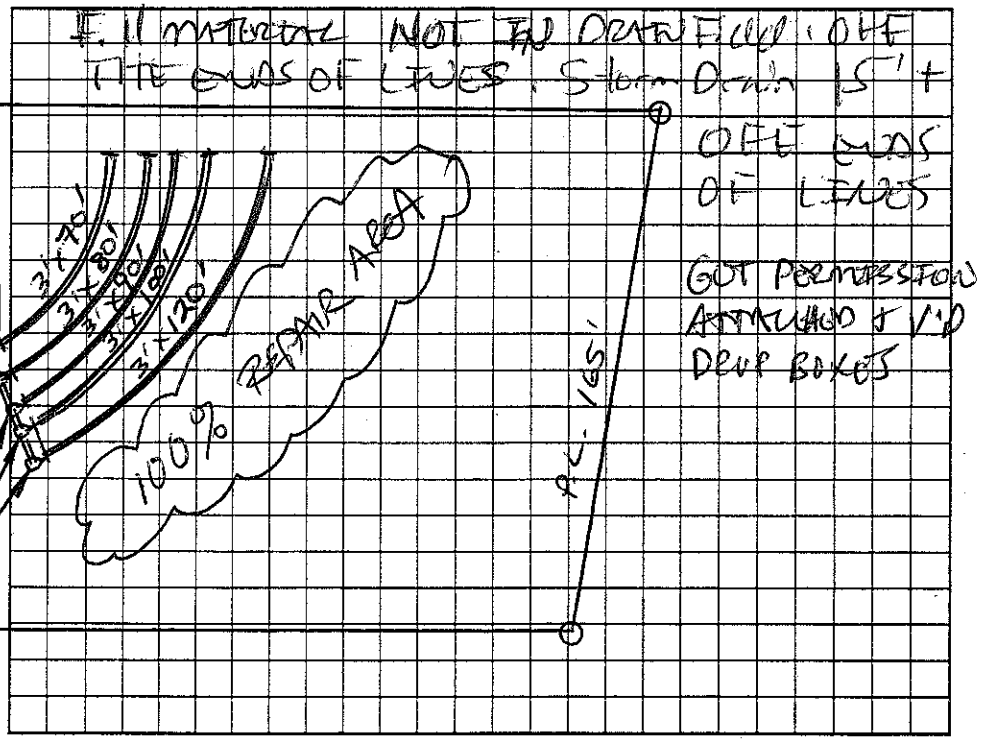

Permit can be suspended or revoked if any false information is supplied toward securing the permit/any unauthorized changes are made to the site/any unauthorized changes are made in the installation of the system. Improvement Permit with plat valid without expiration. Improvement Permit with site plan valid for sixty months. Authorization to Construct is valid for a period equal to that of Improvement Permit – not to exceed sixty months.

Signed: ____ date 3/28/06 Installed by: CURT DUNNING

Improvement Permit by: STEVE HEDRICK date 3-28-06 Operation Permit by: ____ date 12-11-07

Authorization to Construct by: STEVE HEDRICK date 3-28-06 Existing System Inspection by: ____ date ____

HEALTH DEPT. COPY: WHITE OWNER COPY (FINAL): YELLOW OWNER COPY (INITIAL): PINK

Bannister Builders
PO Box 997
Troutman, NC 28166
December 11, 2007

To whom it may concern:

The septic system and leech field, located at 2809 Amity Hill Rd, Statesville, NC 28677, are placed within the property of the above and positioned with a minimum 10 foot buffer from the edge of the property line. No portion of the above system is on or within the adjoining property.

All property lines were surveyed and positioned, in good faith, by Piedmont Design Associates of Mooresville, NC and all measurements and layouts of the above septic system are based on those measurements and on the drawings of the Health Department.

Sincerely,

HB

Horatio Bannister
President