IREDELL COUNTY HEALTH DEPARTMENT

STATESVILLE 704-878-5305 MOORESVILLE 704-664-5281

IMPROVEMENT PERMIT / AUTHORIZATION TO CONSTRUCT / OPERATION PERMIT / EXISTING SYSTEM INSPECTION

PERMIT# 78108 PIN# 4742867300 DATE 12-11-98

OWNER OR CONTRACTOR Larry Brown PHONE: Business 873-0020 Home

ADDRESS 180 Mona Lane Statesville N.C.

LOCATION I-77 S TL Amity Hill Rd TL Dove'y TL Mona 100yds RT

SUBDIVISION BLOCK / SECTION LOT 7 LOT AREA 5.87 acres SITE CLASS PS DESIGN FLOW 100 gpd L.T.A.R. .3

Septic Tank: 1000 Gallons; STB 925 Date 11-4-98
Pump Tank: Gallons; PT Date
Pump Make: Model Serial No.
Nitrification Field: No Fields 1 Square Feet 333 Linear Feet 112
No Lines 1 Trench Width 36" Max Trench Bottom Depth 36" Gravel Depth 12"

☐ New System ☐ Repair System Type: ☐ I ☒ III, IV, V, VI
System Description: Conv. Gravity
Repair System Description: " "
Maintenance Agreement Required: ☐ Yes ☒ No


☐ House/Mod. Home No. Bedrooms
☐ Mobile Home No. Bathrooms
☐ Business No. Employees 4
☐ Other MH Sales Lot
☐ Slab ☐ Crawl Space ☐ Basement w/plumbing ☐ Basement wo/plumbing

Water Supply: ☐ Individual ☐ Public ☒ Community


Comments:/Conditions: Grass over S.T. System

Comments:/Conditions:

INITIAL SITE SKETCH

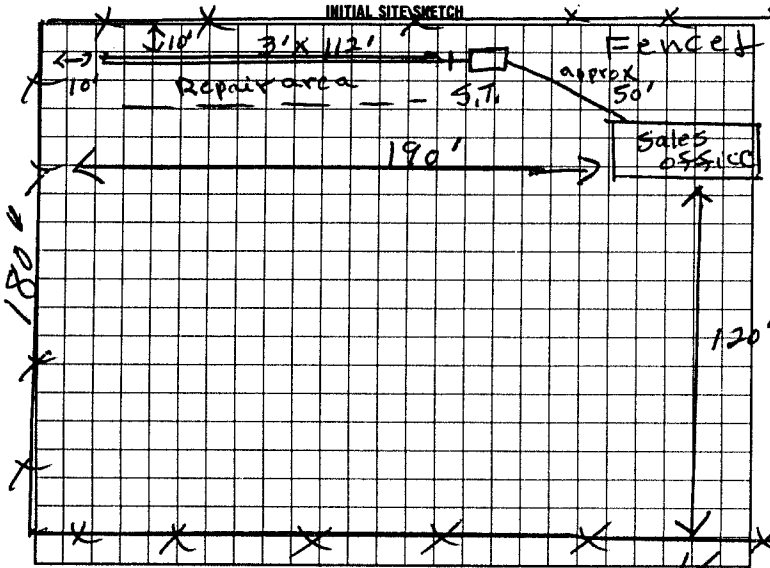

AS BUILT SKETCH

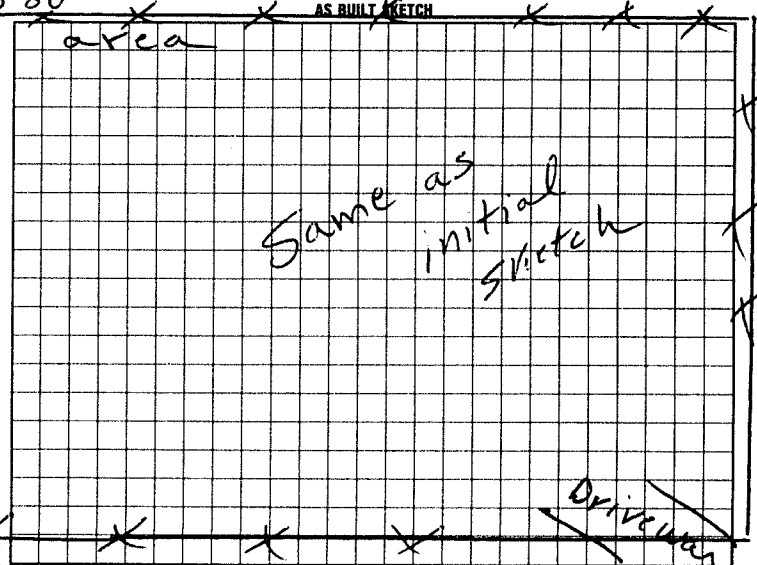

I understand that this permit can be suspended or revoked if any false information is supplied toward securing the permit, any unauthorized changes are made to the site/any unauthorized changes are made in the installation of the system. Improvement Permit with plat valid without expiration. Improvement Permit with site plan valid for sixty months. Authorization to Construct is valid for a period equal to that of Improvement Permit – not to exceed sixty months.

Signed: Larry M Brown date Installed by: Piedmont S.T. Rowan Co

Improvement Permit by: R. C. Moore date 12-11-98 Operation Permit by: R. C. Moore date 1-5-99

Authorization to Construct by: R. C. Moore date 12-11-98 Existing System Inspection by: date

HEALTH DEPT. COPY (FINAL) WHITE INSPECTION COPY (FINAL) GREEN OWNER COPY (FINAL) YELLOW INSPECTION COPY (INITIAL) PINK OWNER COPY (INITIAL) GOLD