A

IREDELL COUNTY HEALTH DEPARTMENT

STATESVILLE 704-878-5305 MOORESVILLE 704-664-5281

IMPROVEMENT PERMIT / AUTHORIZATION TO CONSTRUCT / OPERATION PERMIT / EXISTING SYSTEM INSPECTION

PERMIT# 10247020 PIN# 4742867300 DATE 9/27/2001

OWNER OR CONTRACTOR Piedmont Charlotte Dev. PHONE: Business 704 791-5179 Home

ADDRESS 134 KOA Ln Statesville NC

LOCATION I-77 North exit 45 head towards Northbound I-77 ramp follow signs to campground

SUBDIVISION BLOCK / SECTION LOT LOT AREA SITE CLASS DESIGN FLOW L(T)A.R.

Septic Tank: Existing Gallons: STB Date

Pump Tank: Gallons: PT Date

Pump Make: Model Serial No.

Nitrification Field: No Fields Square Feet Linear Feet

No Lines Trench Width Max. Trench Bottom Depth Existing Gravel Depth

☐ New System ☐ Repair System Type: (I), II, IV, V, VI

System Description: Gravity Conv.

Repair System Description: Same

Maintenance Agreement Required: ☐ Yes ☐ No

☐ Slab X Crawl Space ☐ Basement w/plumbing ☐ Basement wo/plumbing

☐ House/Mod. Home No. Bedrooms

X Mobile Home No. Bathrooms

X Business No. Employees 4


☐ Other

Water Supply: ☐ Individual ☐ Public X Community


Comments/Conditions: Existing Septic System appears to be functioning okay at time of inspection, No problems Noticed

Comments/Conditions: Supply line from Office to SI needs "clean outs" every 50'-100' per plumbing code. Original system installed 1999

INITIAL SITE SKETCH

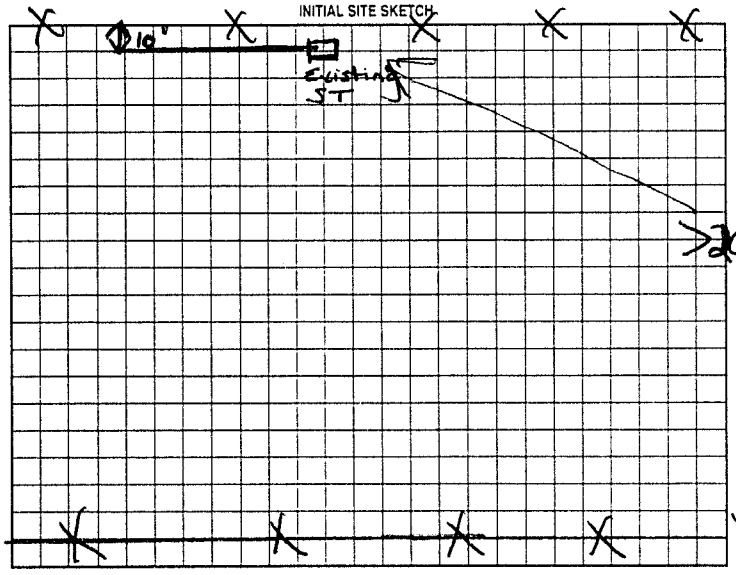

AS BUILT SKETCH

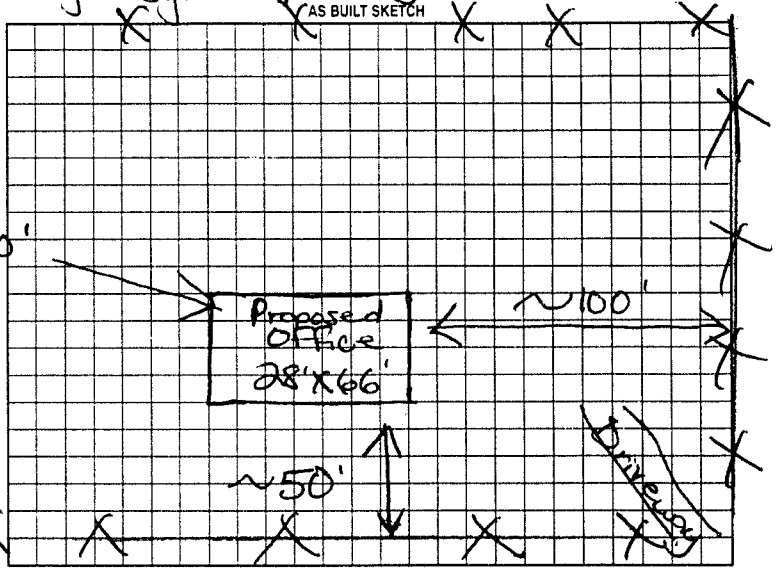

Permit can be suspended or revoked if any false information is supplied toward securing the permit/any unauthorized changes are made to the site/any unauthorized changes are made in the installation of the system. Improvement Permit with plat valid without expiration. Improvement Permit with site plan valid for sixty months. Authorization to Construct is valid for a period equal to that of Improvement Permit – not to exceed sixty months.

Signed: X date Installed by:

Improvement Permit by: Myra H Dotson RS date 9/27/2001 Operation Permit by: date

Authorization to Construct by: date Existing System Inspection by: Myra Dotson date 9/27/2001

HEALTH DEPT. COPY WHITE OWNER COPY (FINAL) YELLOW OWNER COPY (INITIAL) PINK