IREDELL COUNTY HEALTH DEPARTMENT

STATESVILLE 704-878-5305 MOORESVILLE 704-664-5281

IMPROVEMENT PERMIT / CERTIFICATE OF COMPLETION / OPERATION PERMIT / EXISTING SYSTEM INSPECTION

PROPERTY DESCRIPTION NO. 22717 DATE 11-27-95 TAX MAP NO. 50-A-43 Watershed: ☐ Yes ☑ No

OWNER OR CONTRACTOR Lisa Bobbitt PHONE: Business _____ Home 528 9449

ADDRESS 112 Delmar Ln

LOCATION I77 S TL Amity Hill TL Dover TR Dover PK TR Delmar 3rd lot Rt

SUBDIVISION Kentwood MHP BLOCK / SECTION _____ LOT 3 LOT AREA _____ SITE CLASS _____ DESIGN FLOW _____ L.T.A.R. _____

Septic Tank: _____ Gallons; STB _____ Date _____

Pump Tank: _____ Gallons; PT _____ Date _____

Pump Make: _____ Model _____ Serial No. _____

Nitrification Field: No Fields ____ Square Feet _____ Linear Feet _____

No Lines _____ Trench Width _____ Max Trench Bottom Depth _____ Gravel Depth _____

☐ New System ☐ Repair System Type: I. II. III. IV. V. VI

System Description: _____

Repair System Description: _____

Maintenance Agreement Required: ☐ Yes ☐ No

☐ Slab ☑ Crawl Space ☐ Basement w/plumbing ☐ Basement wo/plumbing

☐ House/Mod. Home No. Bedrooms 2

☑ Mobile Home No. Bathrooms 2

☐ Business No. Employees ____

☐ Other _____


Water Supply:
☐ Individual
☑ Community
☐ Public

Comments:

Comments:

INITIAL SITE SKETCH

AS BUILT SKETCH

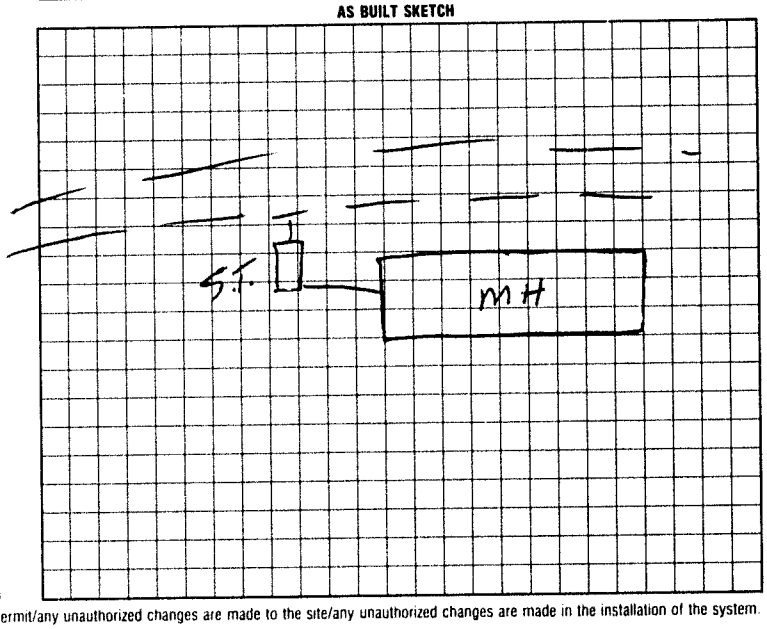

I understand that this permit can be suspended or revoked if any false information is supplied toward securing the permit/any unauthorized changes are made to the site/any unauthorized changes are made in the installation of the system.

Signed: _____

Improvement Permit by: _____ date _____

Existing System Inspection by: L. C. Moore date 11-27-95

Installed by: _____

Certificate of Completion by: _____ date _____

Operation Permit by: _____ date _____

HEALTH DEPT. COPY: WHITE INSPECTION COPY (FINAL): GREEN OWNER COPY (FINAL): YELLOW INSPECTION COPY (INITIAL): PINK OWNER COPY (INITIAL): GOLD