IREDELL COUNTY HEALTH DEPARTMENT

STATESVILLE 704-878-5305 MOORESVILLE 704-664-5281

IMPROVEMENT PERMIT / CERTIFICATE OF COMPLETION / OPERATION PERMIT / EXISTING SYSTEM INSPECTION

PROPERTY DESCRIPTION NO. 16008 DATE 4-4-97 TAX MAP NO. 5D-A-57 Watershed: ☐ Yes ☐ No

OWNER OR CONTRACTOR Joe Hess PHONE: Business Home 872 7372

ADDRESS PO Box 6921 Statesville 28687

LOCATION Amity Hill TL Hugo Lane before cut TR Private Dr. 300' Rt.

SUBDIVISION BLOCK / SECTION LOT LOT AREA 2 acres SITE CLASS. PS DESIGN FLOW 360 L.T.A.R. .3

Septic Tank: 1000 Gallons; STB 1012 Date 1-3-97

Pump Tank: Gallons; PT Date

Pump Make: Model Serial No.

Nitrification Field: No Fields 1 Square Feet 1200 Linear Feet 400

No Lines 3 Trench Width 36" Max Trench Bottom Depth 36" Gravel Depth 12"

☑ New System ☐ Repair System Type: I, II, III, IV, V, VI

System Description: conv. Gravity

Repair System Description: Pump To Chambers

Maintenance Agreement Required: ☐ Yes ☑ No

☑ House/Mod. Home No. Bedrooms 3

☐ Mobile Home No. Bathrooms 2

☐ Business No. Employees

☐ Other


☐ Slab ☐ Crawl Space ☐ Basement w/plumbing ☐ Basement wo/plumbing

Water Supply: ☑ Individual ☐ Community ☐ Public


Comments: Replaces Permit issued 4-21-93

Comments:

INITIAL SITE SKETCH

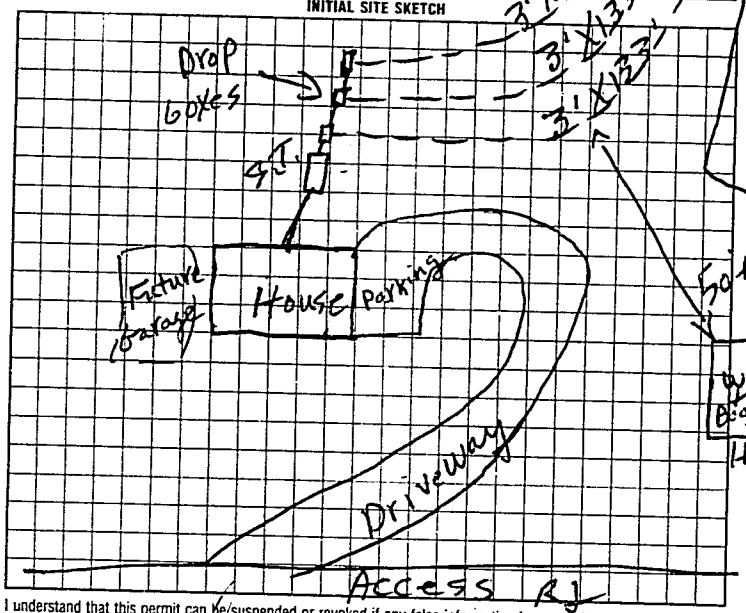

AS BUILT SKETCH

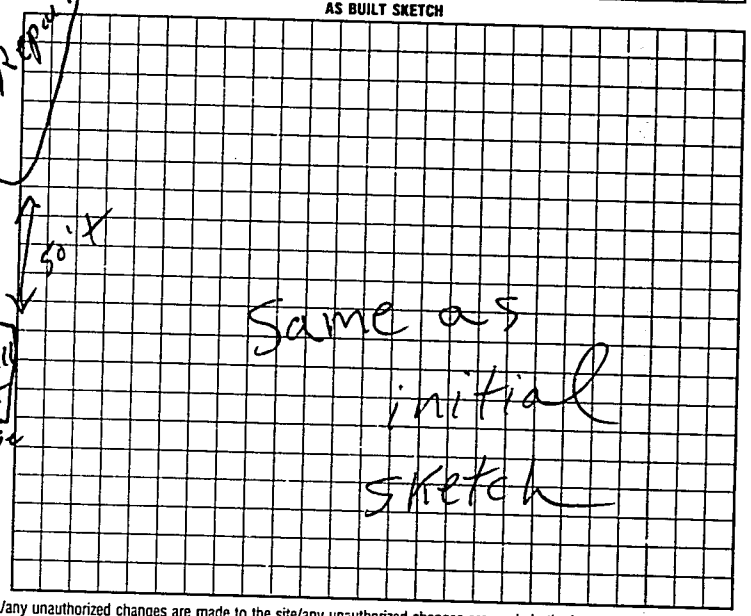

I understand that this permit can be suspended or revoked if any false information is supplied toward securing the permit/any unauthorized changes are made to the site/any unauthorized changes are made in the installation of the system. Improvement Permit is valid for 60 months from date of issuance.

Signed:

Improvement Permit by: F. C. Moore date 4-4-97

Authorization to Cover Existing System Inspection by: F. C. Moore date 4-4-97

Installed by: Elder Elder

Certificate of Completion by: date

Operation Permit by F. C. Moore date 4-16-97

HEALTH DEPT COPY WHITE INSPECTION COPY (INITIAL) GREEN OWNER COPY (FINAL) YELLOW INSPECTION COPY (INITIAL) PINK OWNER COPY (INITIAL) GOLD

to cover. Authorization to cover EXPIRES 60 mos from issue