IREDELL COUNTY HEALTH DEPARTMENT

Statesville Phone TR 3-7271 Mooresville Phone NO 3-1271

PERMIT TO INSTALL SEPTIC TANK

Permit NO. _____ Permit Date 8-6- 1968

Owner H. B. Shaver-Belle Address Arlie Access

Installed By C. Hoke Address Rte. 7 City


Location of Property left off 21 S. at Deerhorn Property left Howard Fuel - R. top hill - cross RR left Arlie Ocus - on R 2 blk.

Tank		Capacity		Length of Lines		Fixtures	
Block	( )	1000	(✓)	225'	(✓)	No. of Baths	( )
Precast	(✓)	1250	( )	250'	( )	Dishwasher	( )
		1500	( )	Other _____		Garbage Grdr.	( )
		Other _____				Other _____	

NOTIFY HEALTH DEPARTMENT AT LEAST EIGHT HOURS BEFORE TANK IS TO BE INSPECTED.

Final Inspection _____ 19__ Approved ( ) Disapproved ( )

Remarks Well 50'

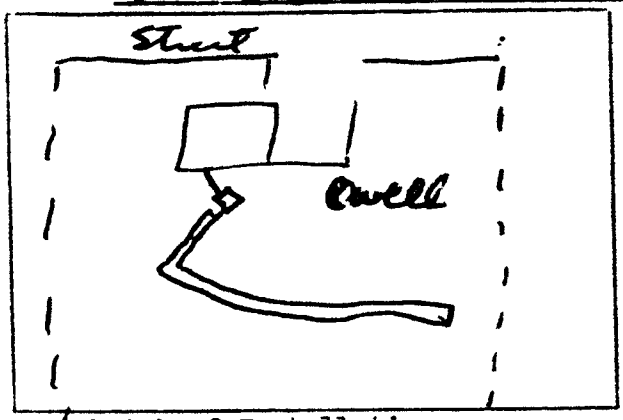

Sketch of Installation

_____

Sanitarian