IREDELL COUNTY HEALTH DEPARTMENT

STATESVILLE 704-878-5305 MOORESVILLE 704-664-5281

IMPROVEMENT PERMIT / CERTIFICATE OF COMPLETION / OPERATION PERMIT / EXISTING SYSTEM INSPECTION

PROPERTY DESCRIPTION NO. 66993 DATE 6-12-97 TAX MAP NO. 4743 01 7241 Watershed: ☐ Yes ☐ No

OWNER OR CONTRACTOR Betty Lee Jones (Wooten) PHONE: Business _____ Home 704 871 8044

ADDRESS 108 Apple valley Ln

LOCATION 215 To Cumberland To Bluebird TR Skyuka TL Arlie Loop Part Apple Valley 1ST bf 1st

SUBDIVISION Arlie Acres BLOCK / SECTION _____ LOT 31 LOT AREA .676 acres SITE CLASS. PS DESIGN FLOW 360 L.T.A.R. .13

Septic Tank: 1000 Gallons; STB 774 Date 6-5-00

Pump Tank: _____ Gallons; PT _____ Date _____

Pump Make: _____ Model _____ Serial No. _____

Nitrification Field: No Fields 1 Square Feet 1200 Linear Feet 400

No Lines 4 Trench Width 36" Max Trench Bottom Depth 36" Gravel Depth 12"

☑ New System ☐ Repair System Type: I, II, III, IV, V, VI

System Description: Conv. Gravity

Repair System Description: Gravity Chambers

Maintenance Agreement Required: ☐ Yes ☑ No

☐ House/Mod. Home No. Bedrooms 3

☑ Mobile Home No. Bathrooms 2

☐ Business No. Employees _____

☐ Other _____


☐ Slab ☑ Crawl Space ☐ Basement w/plumbing ☐ Basement wo/plumbing

Water Supply: ☑ Individual ☐ Community ☐ Public

Comments:

Comments: Installed as shown

INITIAL SITE SKETCH

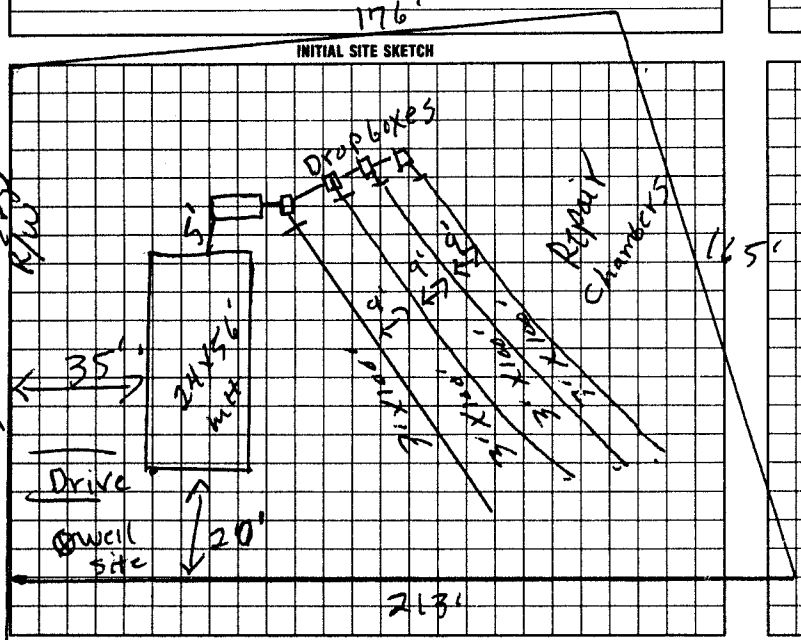

AS BUILT SKETCH

I understand that this permit can be suspended or revoked if any false information is supplied toward securing the permit/any unauthorized changes are made to the site/any unauthorized changes are made in the installation of the system. Improvement Permit is valid for 60 months from date of issuance.

Signed: X Betty L. Jones

Improvement Permit by: P.C. Moore date 6-12-97

Authorization to Construct by: P.C. Moore date 6-12-97

Installed by: Dwight Wooten

Certificate of Completion by: [illegible] date 7-18-00

Operation Permit by: _____ date _____

HEALTH DEPT. COPY: WHITE INSPECTION COPY (FINAL): GREEN OWNER COPY (FINAL): YELLOW INSPECTION COPY (INITIAL): PINK OWNER COPY (INITIAL): GOLD

to count.

Authorization to count EXPIRES 60 MOS from issue