IREDELL COUNTY HEALTH DEPARTMENT

STATESVILLE 704-878-5305 MOORESVILLE 704-664-5281

IMPROVEMENT PERMIT / CERTIFICATE OF COMPLETION / OPERATION PERMIT / EXISTING SYSTEM INSPECTION

PROPERTY DESCRIPTION NO. 18106 DATE 3-25-94 TAX MAP NO. 6F-C-49 Watershed: ☐ Yes ☑ No

OWNER OR CONTRACTOR Wanda Banger PHONE: Business Home 871-8872

ADDRESS Po Box 508 Troutman, N.C.

LOCATION 215 TL moose Club Rd TL Skyuka TR Arlie Loop at end of loop off left

SUBDIVISION BLOCK / SECTION LOT LOT AREA 2.0 acres SITE CLASS. P.S. DESIGN FLOW 360 L.T.A.R. .3 gals/sq ft/day

Septic Tank: 1000 Gallons; STB 1012 Date 3-4-94

Pump Tank: Gallons; PT Date

Pump Make: Model Serial No.

Nitrification Field: No Fields 1 Square Feet 1200 Linear Feet 400

No Lines 3 Trench Width 36" Max Trench Bottom Depth 36" Gravel Depth 12"

☑ New System ☐ Repair System Type: I, (II), III, IV, V, VI

System Description: Conv. Gravity

Repair System Description: Conv. Gravity

Maintenance Agreement Required: ☐ Yes ☐ No

☐ House/Mod. Home ☑ Mobile Home ☐ Business ☐ Other

No. Bedrooms 3 No. Bathrooms 2 No. Employees


☐ Slab ☑ Crawl Space ☐ Basement w/plumbing ☐ Basement wo/plumbing

Water Supply: ☑ Individual ☐ Community ☐ Public


Comments: Run Drain lines on Contaur of slope

Comments: unit had to be moved Because of property line Position therefore lay-out was changed

INITIAL SITE SKETCH

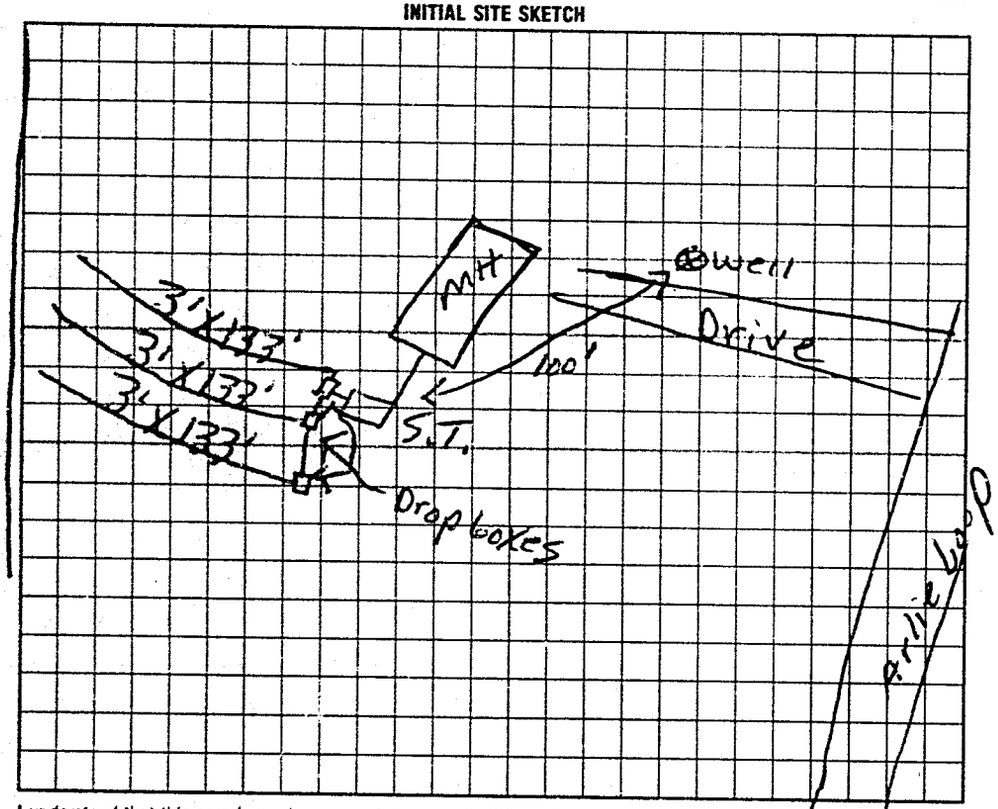

AS BUILT SKETCH

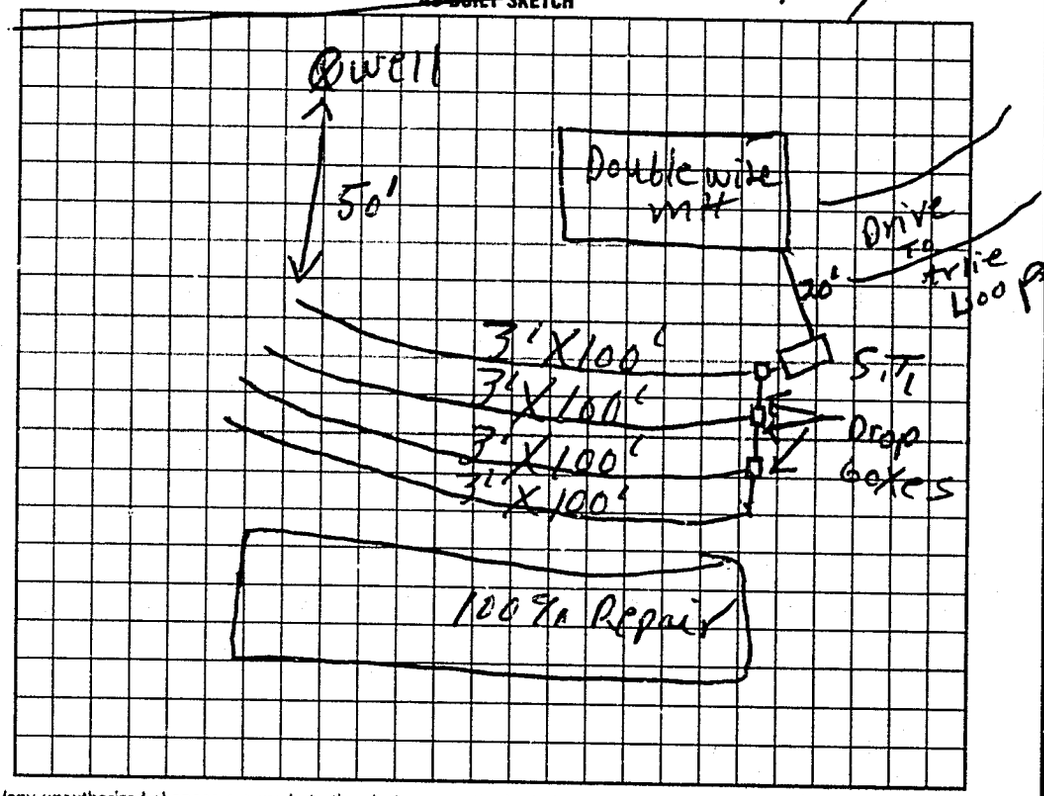

I understand that this permit can be suspended or revoked if any false information is supplied toward securing the permit/any unauthorized changes are made to the site/any unauthorized changes are made in the installation of the system. Improvement Permit is valid for 60 months from date of issuance.

Signed: X Jerald Banger

Improvement Permit by: J.C. moore date 3-25-94

Existing System Inspection by: date

Installed by: Donald Lackey

Certificate of Completion by: J.C. moore date 5-10-94

Operation Permit by: date

HEALTH DEPT. COPY: WHITE INSPECTION COPY (FINAL): GREEN OWNER COPY (FINAL): YELLOW INSPECTION COPY (INITIAL): PINK OWNER COPY (INITIAL): GOLD