IREDELL COUNTY HEALTH DEPARTMENT

STATESVILLE 704-878-5305 MOORESVILLE 704-664-5281

IMPROVEMENT PERMIT / AUTHORIZATION TO CONSTRUCT / OPERATION PERMIT / EXISTING SYSTEM INSPECTION

PERMIT# 72811 PIN# 4774301 9133 DATE 4-13-98

OWNER OR CONTRACTOR Patricia Davis PHONE: Business Home 873 9499

ADDRESS PO Box 1092 Troutman, N.C.

LOCATION Arlie Loop on left after Apple Valley (23N Arlie Loop)

SUBDIVISION BLOCK / SECTION LOT LOT AREA 1.8 acres SITE CLASS. PS DESIGN FLOW 340 L.T.A.R. .3

Septic Tank: 1000 Gallons; STB 1007 Date 3-11-00

Pump Tank: Gallons; PT Date

Pump Make: Model Serial No.

Nitrification Field: No Fields 4 Square Feet 140 Linear Feet 280

No Lines 4 Trench Width 36" Max Trench Bottom Depth 36" Gravel Depth 12"

☑ New System ☐ Repair System Type: I, II, III, IV, V, VI

System Description: Conv. Gravity

Repair System Description: Pump To Chamber

Maintenance Agreement Required: ☐ Yes ☐ No

☐ Slab ☑ Crawl Space ☐ Basement w/plumbing ☐ Basement wo/plumbing

☐ House/Mod. Home No. Bedrooms 2

☑ Mobile Home No. Bathrooms 1

☐ Business No. Employees

☐ Other

Water Supply: ☑ Individual ☐ Public ☐ Community

Comments:/Conditions:



INITIAL SITE SKETCH

Comments:/Conditions:

AS BUILT SKETCH

Same as initial sketch

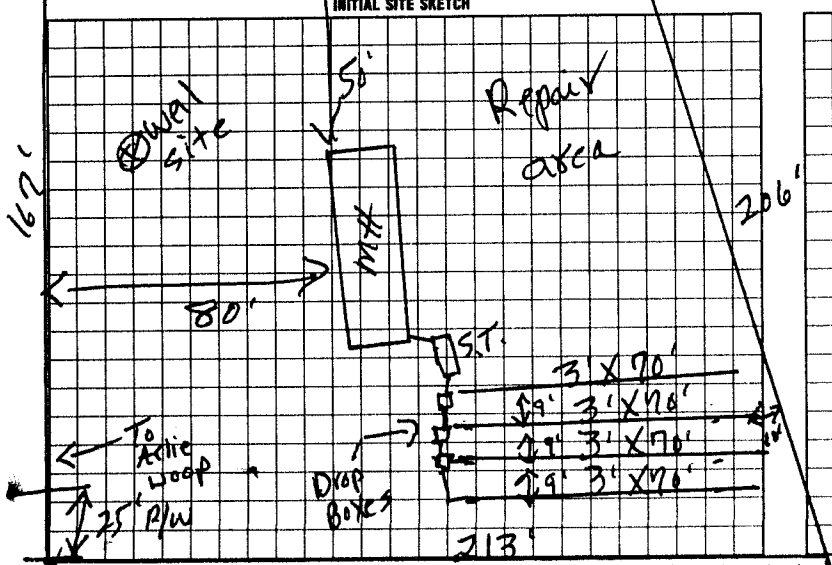

I understand that this permit can be suspended or revoked if any false information is supplied toward securing the permit/any unauthorized changes are made to the site/any unauthorized changes are made in the installation of the system. Improvement Permit with plat valid without expiration. Improvement Permit with site plan valid for sixty months. Authorization to Construct is valid for a period equal to that of Improvement Permit – not to exceed sixty months.

Signed: X Chester Jones date

Improvement Permit by: E.C. Moore date 4-13-98

Authorization to Construct by: E.C. Moore date 4-13-98

Installed by: Bill Adams

Operation Permit by: E.C. Moore date 4-20-00

Existing System Inspection by: date

HEALTH DEPT. COPY: WHITE INSPECTION COPY (FINAL): GREEN OWNER COPY (FINAL): YELLOW INSPECTION COPY (INITIAL): PINK OWNER COPY (INITIAL): GOLD