IREDELL COUNTY HEALTH DEPARTMENT - *ENVIRONMENTAL HEALTH* ☐ STATESVILLE OFFICE 704-878-5305 ☐ MOORESVILLE OFFICE 704-664-5281

IMPROVEMENT PERMIT / AUTHORIZATION TO CONSTRUCT / OPERATION PERMIT / EXISTING SYSTEM INSPECTION

PERMIT # REPAIR PIN # 4743-07-5416 DATE APRIL 17, 2012

OWNER WILSON GOD FREY APPLICANT: DAVID YOUNTZ PHONE: Home/Cell # 704-872-6366 Business #

SITE ADDRESS ~~4893 WILKESBORO HWY~~ OWNER / APPLICANT ADDRESS 4893 W WILKESBORO HIGHWAY

SITE DIRECTIONS 1707 SHELTON AVENUE

SUBDIVISION CASHION BLOCK / SECTION III LOT # 4 LOT AREA 0.4 ACRE DESIGN FLOW 360 L.T.A.R. 0.3 GPD/FT

Septic Tank EXIST Gallons: STB Date

Pump Tank Gallons: P T Date

Pump Make Model Serial #

No. Nitrification Fields: 1 No. Lines 2 Linear Feet 120

Trench Width 36" Max. Trench Bottom Depth 36" Gravel Depth N/A

☐ New System ☑ Repair ☐ Expansion System Type I II III IV V VI

System Description:

Repair System Description: 25% REDUCTION, GRAVITY

Maintenance Agreement Required ☐ YES ☒ NO

☐ GRAVITY ☐ PRESSURE

☒ Residence No. Bedrooms 3

☐ Business No. Persons

☐ Other No. Employees


☐ Slab ☒ Crawl Space

☐ Basement w/plumbing ☐ Basement w/o plumbing


Water Supply: ☐ Private ☑ Public ☐ Community

Comments / Conditions

INITIAL SITE SKETCH

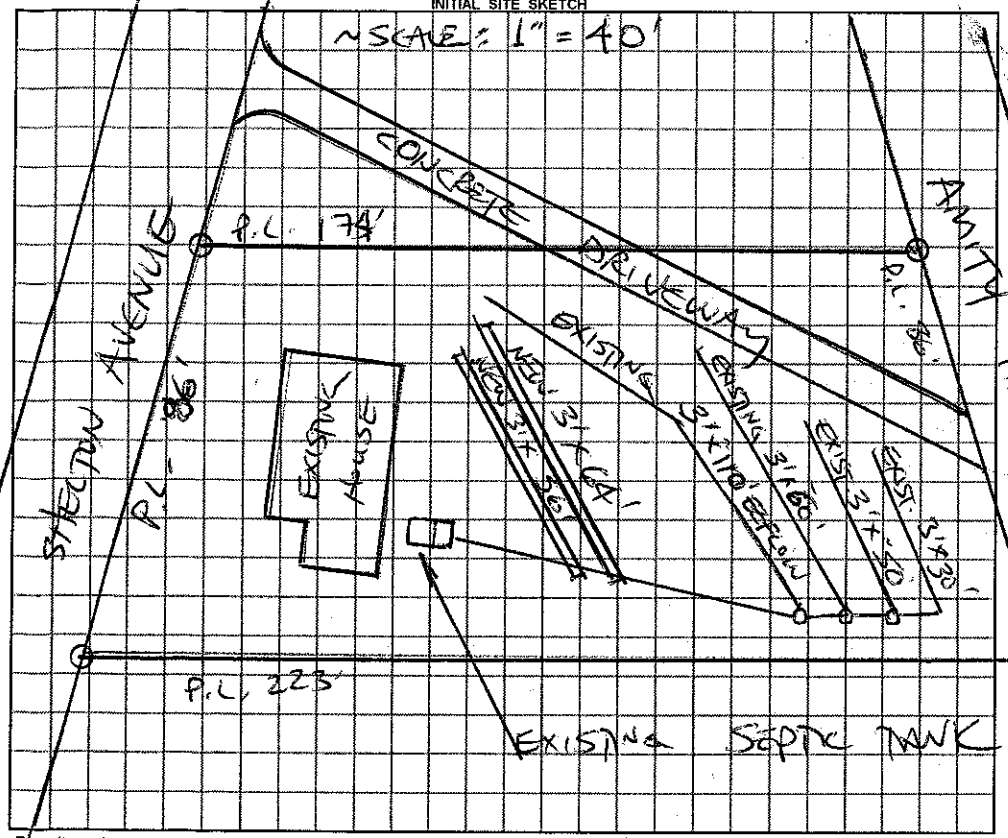

AS BUILT SKETCH

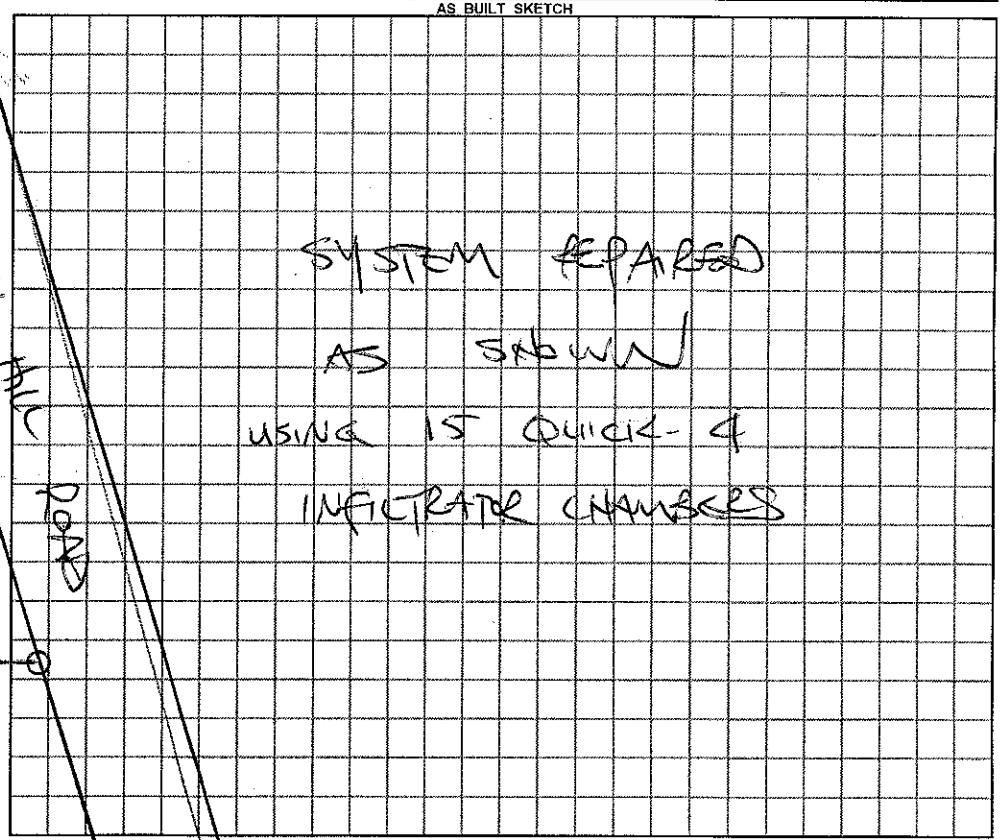

Permit can be suspended or revoked if any false information is supplied toward securing the permit / any unauthorized changes are made to the site / any unauthorized changes are made in the installation of the system.

☐ ***IMPROVEMENT PERMIT*** *with plat valid without expiration.* ☑ ***IMPROVEMENT PERMIT*** *with ~~plat valid without expiration.~~ site plan valid 60 mo.* ☑ ***AUTHORIZATION TO CONSTRUCT*** valid for period equal to IMPROVEMENT PERMIT–not to exceed 60 mo.

Owner / Applicant Signature: David P Yountz Date

IMPROVEMENT PERMIT by: STEVE HERRICK REHS Date 4.17.12

AUTHORIZATION TO CONSTRUCT by: STEVE HERRICK REHS Date 4.17.12

YOU SHOULD CONTACT A LOCATOR SERVICE PRIOR TO ANY EXCAVATION

Installed by: YOUNTZ GRADING

OPERATION PERMIT by: STEVE HERRICK REHS Date 4-18-12

Existing System Inspected by: REHS Date

White Copy – Environmental Health YELLOW COPY (Final) Owner / Applicant PINK COPY (Initial) Owner / Applicant