IREDELL COUNTY HEALTH DEPARTMENT

STATESVILLE 704-878-5305 MOORESVILLE 704-664-5281

IMPROVEMENT PERMIT / AUTHORIZATION TO CONSTRUCT / OPERATION PERMIT / EXISTING SYSTEM INSPECTION

PERMIT# REPAIR PIN# 4743-07-5416 DATE 4-3-06

OWNER OR CONTRACTOR WILSON GODFREY PHONE: Business 704-872-6366 Home

ADDRESS 4893 WILKESBORO Hwy STATESVILLE NC 28625-2164

LOCATION US 21 South TL Amity Hill Road, on Right Across from Godfrey Lumber Co.

SUBDIVISION CASTON BLOCK / SECTION III LOT 4 LOT AREA 0.4 Acre SITE CLASS. PS DESIGN FLOW 360 L.T.A.R. EXISTING 0.3 GPD/FT

Septic Tank: EXISTING Gallons; STB Date

Pump Tank: Gallons; PT Date

Pump Make: Model Serial No.

Nitrification Field: No Fields 1 Square Feet 1008 Linear Feet 252

No Lines Four Trench Width 36" Max Trench Bottom Depth 36" Gravel Depth N/A

☐ New System ☑ Repair System Type: I, (II), III, IV, V, VI

System Description:

Repair System Description: 25% Reduction, Gravity

Maintenance Agreement Required: ☐ Yes ☑ No

☑ House/Mod. Home No. Bedrooms 3

☐ Mobile Home No. Bathrooms

☐ Business No. Employees

☐ Other


☐ Slab ☑ Crawl Space ☐ Basement w/plumbing ☐ Basement wo/plumbing

Water Supply: ☐ Individual ☑ Public ☐ Community

Comments:/Conditions: (1) INSTALL NEW 25% REDUCTION SYSTEM AS FLAGGED ON SITE (2) THIS PERMIT SERVES AS "NOTICE of VIOLATION," SYSTEM TO BE REPAIRED BY 5-3-06

Comments:/Conditions:

INITIAL SITE SKETCH

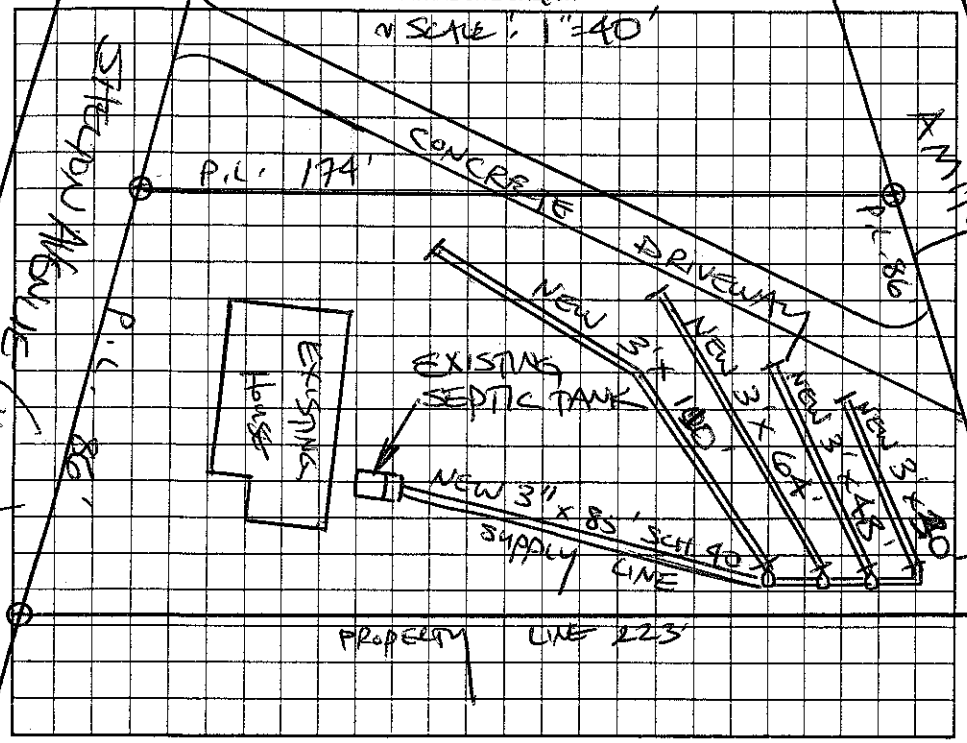

AS BUILT SKETCH

SYSTEM REPAIRED ACCORDING TO INITAL SITE SKETCH

Permit can be suspended or revoked if any false information is supplied toward securing the permit/any unauthorized changes are made to the site/any unauthorized changes are made in the installation of the system. Improvement Permit with plat valid without expiration. Improvement Permit with site plan valid for sixty months. Authorization to Construct is valid for a period equal to that of Improvement Permit – not to exceed sixty months.

Signed: Wilson S. Godfrey date 4-5-06 Installed by: ANDY DAVIES

Improvement Permit by: STEVE HEDRICK date 4-3-06 Operation Permit by: STEVE HEDRICK date 5-2-06

Authorization to Construct by: STEVE HEDRICK date 4-3-06 Existing System Inspection by: date

HEALTH DEPT. COPY: WHITE OWNER COPY (FINAL): YELLOW OWNER COPY (INITIAL): PINK