# IREDELL COUNTY HEALTH DEPARTMENT

STATESVILLE 704-878-5305 MOORESVILLE 704-664-5281

## IMPROVEMENT PERMIT / AUTHORIZATION TO CONSTRUCT / OPERATION PERMIT / EXISTING SYSTEM INSPECTION

PERMIT# REPAIR PIN# 4743-07-5416 DATE 8-2-04

OWNER OR CONTRACTOR WILMA S. GODFREY PHONE: Business 704-872-6366 Home 704-592-8033

ADDRESS 4893 WILKESBORO Hwy, STATESVILLE NC 28625

LOCATION US 21 SOUTH, TL AMITY HILL ROAD, 3RD HOUSE ON RIGHT

SUBDIVISION CASHION BLOCK / SECTION _____ LOT 3, 4 (1) LOT AREA 0.37 ACRE SITE CLASS. PS DESIGN FLOW 360 L.T.A.R. EXISTING

Septic Tank: 1000 Gallons; STB 1012 Date 4-30-04
Pump Tank: _____ Gallons; PT _____ Date _____
Pump Make: _____ Model _____ Serial No. _____
Nitrification Field: No Fields 1 Square Feet _____ Linear Feet EXISTING
No Lines _____ Trench Width _____ Max Trench Bottom Depth _____ Gravel Depth _____

☐ New System ☑ Repair System Type: I, II, III, IV, V, VI
System Description: _____
Repair System Description: CONVENTIONAL, GRAVITY
Maintenance Agreement Required: ☐ Yes ☑ No


☑ House/Mod. Home No. Bedrooms 3
☐ Mobile Home No. Bathrooms 1
☐ Business No. Employees ____
☐ Other _____
☐ Slab ☑ Crawl Space ☐ Basement w/plumbing ☐ Basement wo/plumbing

Water Supply: ☐ Individual ☑ Public ☐ Community


Comments:/Conditions: CRUSH EXISTING SEPTIC TANK & FILL WITH SOIL FROM NEW TANK HOLE. THIS PERMIT SERVES AS "NOTICE of VIOLATION", SYSTEM TO BE REPAIRED BY 9-2-04

Comments:/Conditions: SEPTIC TANK W/ MARKER INSTALLED USING ~~ACCESS~~ "TUFTITE" FILTER

INITIAL SITE SKETCH

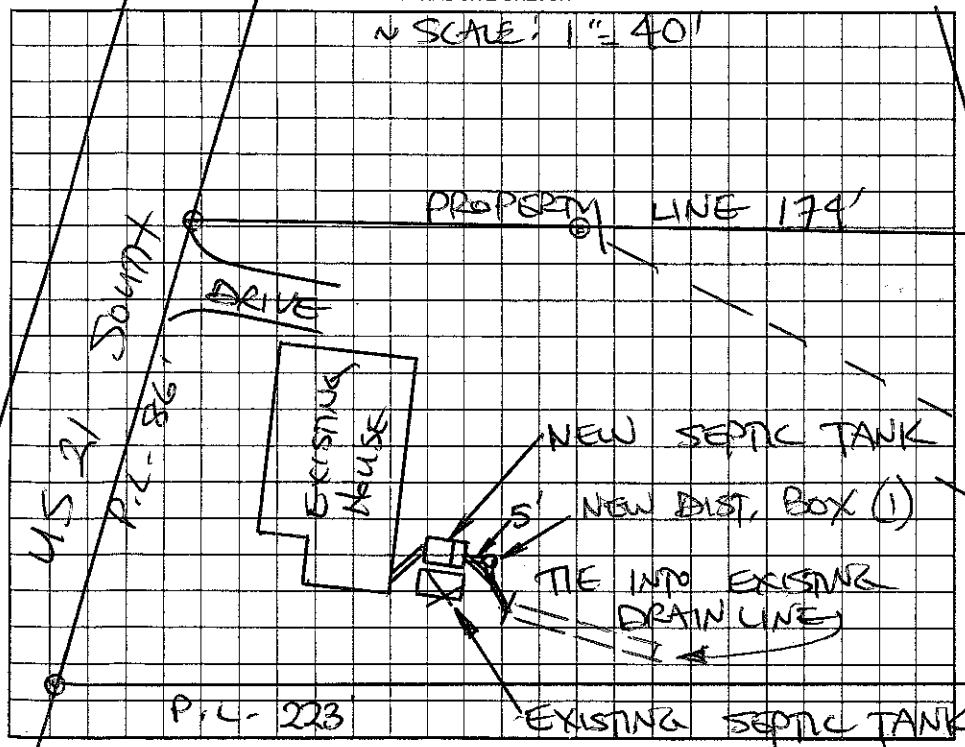


AS BUILT SKETCH

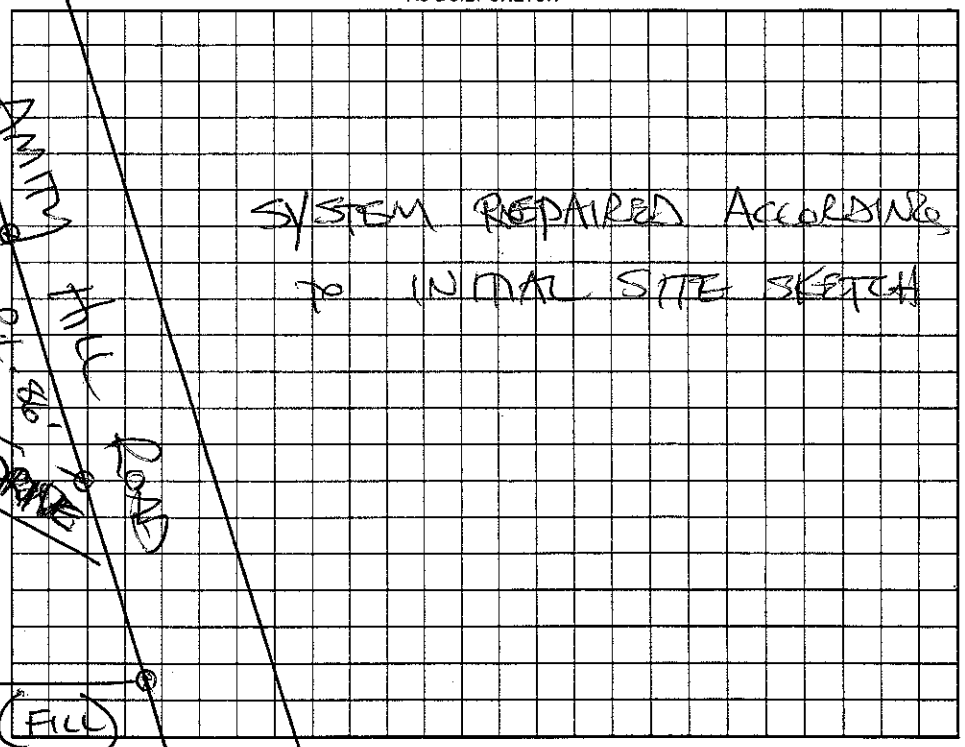


Permit can be suspended or revoked if any false information is supplied toward securing the permit/any unauthorized changes are made to the site/any unauthorized changes are made in the installation of the system. Improvement Permit with plat valid without expiration. Improvement Permit with site plan valid for sixty months. Authorization to Construct is valid for a period equal to that of Improvement Permit – not to exceed sixty months.

Signed: [signature] date 8-2-04

Improvement Permit by: STEVE HENDRICK date 8-2-04

Authorization to Construct by: STEVE HENDRICK date 8-2-04

Installed by: PIEDMONT BACKHOE

Operation Permit by: STEVE HENDRICK date 8-17-04

Existing System Inspection by: _____ date _____

HEALTH DEPT. COPY: WHITE OWNER COPY (FINAL): YELLOW OWNER COPY (INITIAL): PINK