Voids previous dated Permits

IREDELL COUNTY HEALTH DEPARTMENT

STATESVILLE 704-878-5305 MOORESVILLE 704-664-5281

IMPROVEMENT PERMIT / AUTHORIZATION TO CONSTRUCT / OPERATION PERMIT / EXISTING SYSTEM INSPECTION

PERMIT# 73742 PIN# 4743105847 pt DATE June 9 2000

OWNER OR CONTRACTOR Fox Den Acres PHONE: Business 569 7836 Home

ADDRESS 5201 Monroe Rd ~~Statesville~~ Charlotte, NC

LOCATION Hwy 21 S to Moose Club Rd (L) Skyuka Dr (R) Artie Loop To Apple Valley (R) Boyuer To end

SUBDIVISION Apple Valley BLOCK / SECTION LOT 5 LOT AREA 2.69 Ac SITE CLASS PS DESIGN FLOW 360 L.T.A.R. 3

Septic Tank: 1000 Gallons: STB 1012 Date 2 13 00
Pump Tank: 1000 Gallons: PT 17 Date 1 11 2000
Pump Make: HydroMATic Model SK50 Serial No.
Nitrification Field: No Fields 1 Square Feet 1200 Lineal Feet 300
No Lines 3 Trench Width 36" Max Trench Bottom Depth 36

☑ New System ☐ Repair System Type I, II, III, IV, V, VI
System Description: Pump 25% Reduction
Repair System Description: Pump 30% Reduction
Maintenance Agreement Required: ☐ Yes ☑ No


☑ House/Mod. Home ☐ Mobile Home ☐ Business ☐ Other
No. Bedrooms 3 No. Bathrooms 2 No. Employees
☐ Slab ☑ Crawl Space ☐ Basement w/plumbing ☐ Basement wo/plumbing

Water Supply: ☑ Individual ☐ Public ☐ Community
WELL

Comments/Conditions: Locate Well 100ft from Any part of Septic
3, 5 Item. 48-50 chambers 30 HDS Sections

Comments/Conditions 48 Infiltrator Chambers Used
6-12 Lines & Tanks Installed As shown
7-7 Pressure Set
8-3 Alarm Elec ✓

INITIAL SITE SKETCH

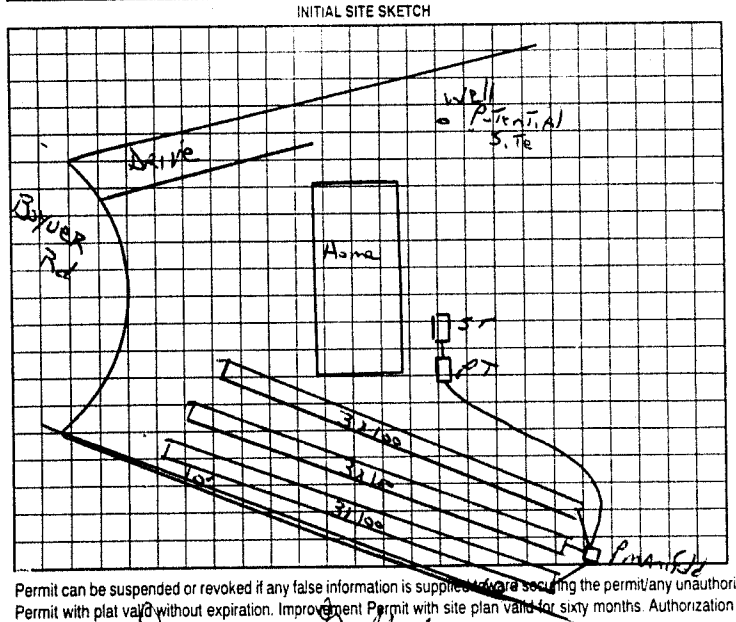

AS BUILT SKETCH

Note ends of line have been driven over - Need to keep Traffic off system
recommend 2nd riser ~~extend~~ on pump tank due to landscaping.

Permit can be suspended or revoked if any false information is supplied, work securing the permit/any unauthorized changes are made to the site/any unauthorized changes are made in the installation of the system. Improvement Permit with plat valid without expiration. Improvement Permit with site plan valid for sixty months. Authorization to Construct is valid for a period equal to that of Improvement Permit – not to exceed sixty months.

Signed: Donna Pollard date

Improvement Permit by: Joe Potter date June 9 2000

Authorization to Construct by: Joe Potter date June 9 2000

Installed by: Al Brock Inc

Operation Permit by: M&C Contr date 8-3-00

Existing System Inspection by: date

HEALTH DEPT. COPY WHITE OWNER COPY (FINAL) YELLOW OWNER COPY (INITIAL) PINK