This Void Previous Permit

IREDELL COUNTY HEALTH DEPARTMENT

STATESVILLE 704-878-5305
MOORESVILLE 704-664-5281

IMPROVEMENT PERMIT / AUTHORIZATION TO CONSTRUCT / OPERATION PERMIT / EXISTING SYSTEM INSPECTION

PERMIT# 86821 PIN# 4743105847 pt DATE May 31, 2000

OWNER OR CONTRACTOR Fox Den Acres PHONE: Business 567 9820 Home

ADDRESS 5201 Monroe Rd Charlotte NC

LOCATION Hwy 21 South (L) Moose Club (L) Skyuka Rd (R) Arlie Coop STRAIGHT to end Lot on Right up hill

SUBDIVISION Apple Valley BLOCK / SECTION LOT 16 LOT AREA 6.14 Ac SITE CLASS PS DESIGN FLOW 360 L.T.A.R. .3

Septic Tank: 1000 Gallons: STB 1012 Date 1/29/00
Pump Tank: Gallons: PT Date
Pump Make: Model Serial No.
Nitrification Field: No Fields 1 Square Feet 1200 Other Feet 300
No Lines 3 Trench Width 36" Max Trench Bottom Depth 24" Gravel Depth N/A

☒ New System ☐ Repair System Type: I, II, (III) IV, V, VI
System Description: GRAVITY 25% Reduction
Repair System Description: Pump
Maintenance Agreement Required: ☐ Yes ☒ No

☐ House/Mod. Home No. Bedrooms 3
☐ Mobile Home No. Bathrooms 2
☐ Business No. Employees
☐ Other
☐ Slab ☐ Crawl Space ☐ Basement w/plumbing ☐ Basement wo/plumbing


Water Supply: ☒ Individual ☐ Public ☐ Community

Comments/Conditions:


NOT TO SCALE

Comments/Conditions

INITIAL SITE SKETCH

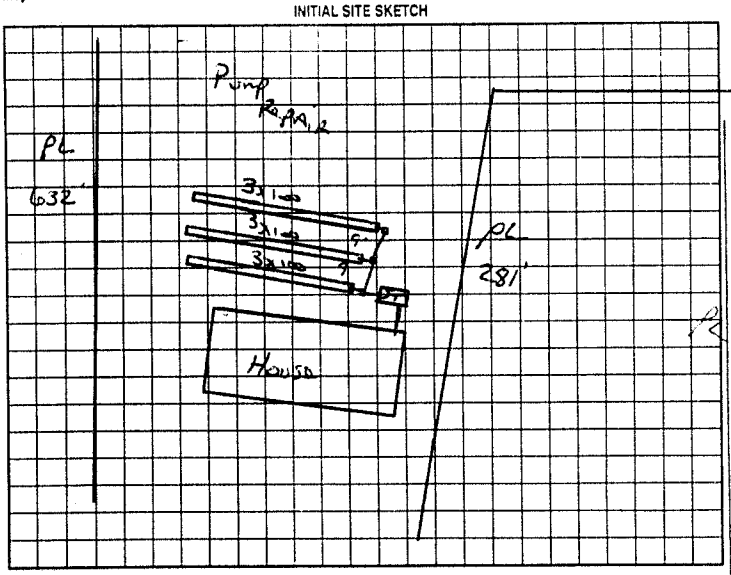

AS BUILT SKETCH

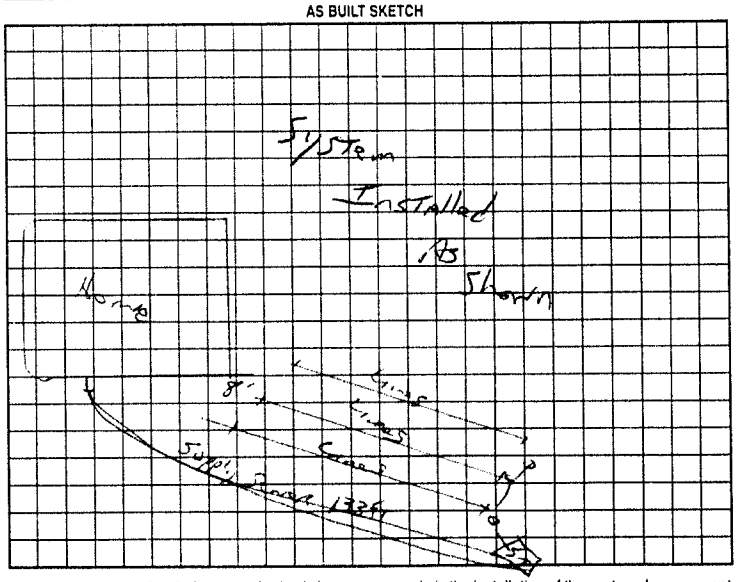

Permit can be suspended or revoked if any false information is supplied toward securing the permit/any unauthorized changes are made to the site/any unauthorized changes are made in the installation of the system. Improvement Permit with plat valid without expiration. Improvement Permit with site plan valid for sixty months. Authorization to Construct is valid for a period equal to that of Improvement Permit – not to exceed sixty months.

Signed: date

Improvement Permit by: G.C. Potter date May 31 00

Authorization to Construct by: G.C. Potter date May 31 00

Installed by: Al Backhoe

Operation Permit by: G.C. Potter date June 1 - 2000

Existing System Inspection by: date

HEALTH DEPT. COPY: WHITE OWNER COPY (FINAL): YELLOW OWNER COPY (INITIAL): PINK