IREDELL COUNTY HEALTH DEPARTMENT

STATESVILLE 704-878-5305 125.00 (14) MOORESVILLE 704-664-5281

IMPROVEMENT PERMIT / AUTHORIZATION TO CONSTRUCT / OPERATION PERMIT / EXISTING SYSTEM INSPECTION

PERMIT# 086818 PIN# 4743105847 PT DATE 4/4/00

OWNER OR CONTRACTOR FOX DEN ACRES PHONE: Business 568-9839 Home

ADDRESS 5201 MONROE RD CHARLOTTE NC 28205

LOCATION 115 S - TL MOOSE CLUB RD - TL SYKUKA RD - TR ARLEE LOOP TO APPLE VALLEY. ON RT

SUBDIVISION APPLE VALLEY BLOCK / SECTION LOT 14 LOT AREA 1.17AC SITE CLASS PS DESIGN FLOW 360 GPD L.T.A.R. .3 g/ft²

Septic Tank: 1000 Gallons; STB Date

Pump Tank: Gallons; PT Date

Pump Make: Model Serial No.

Nitrification Field: No Fields 1 Square Feet 900 Linear Feet 300

No Lines 3@100' Trench Width 36" Max Trench Bottom Depth 18-24" Gravel Depth 12"

☑ New System ☐ Repair System Type: I, II, (III), IV, V, VI

System Description: GRAVITY INNOVATIVE

Repair System Description: SAME

Maintenance Agreement Required: ☐ Yes ☑ No

☐ House/Mod. Home ☑ Mobile Home ☐ Business ☐ Other

No. Bedrooms 3 No. Bathrooms 2 No. Employees


☐ Slab ☑ Crawl Space ☐ Basement w/plumbing ☐ Basement wo/plumbing

Water Supply: ☑ Individual ☐ Public ☐ Community


Comments:/Conditions:

Comments:/Conditions: ① SYSTEM ALTERED AS SHOWN W/ PRIOR HEALTH DEPT. APPROVAL ② SEPTIC TANK WITH MARKER INSTALLED USING "POLYLOK" FILTER.

INITIAL SITE SKETCH 1" = 50'

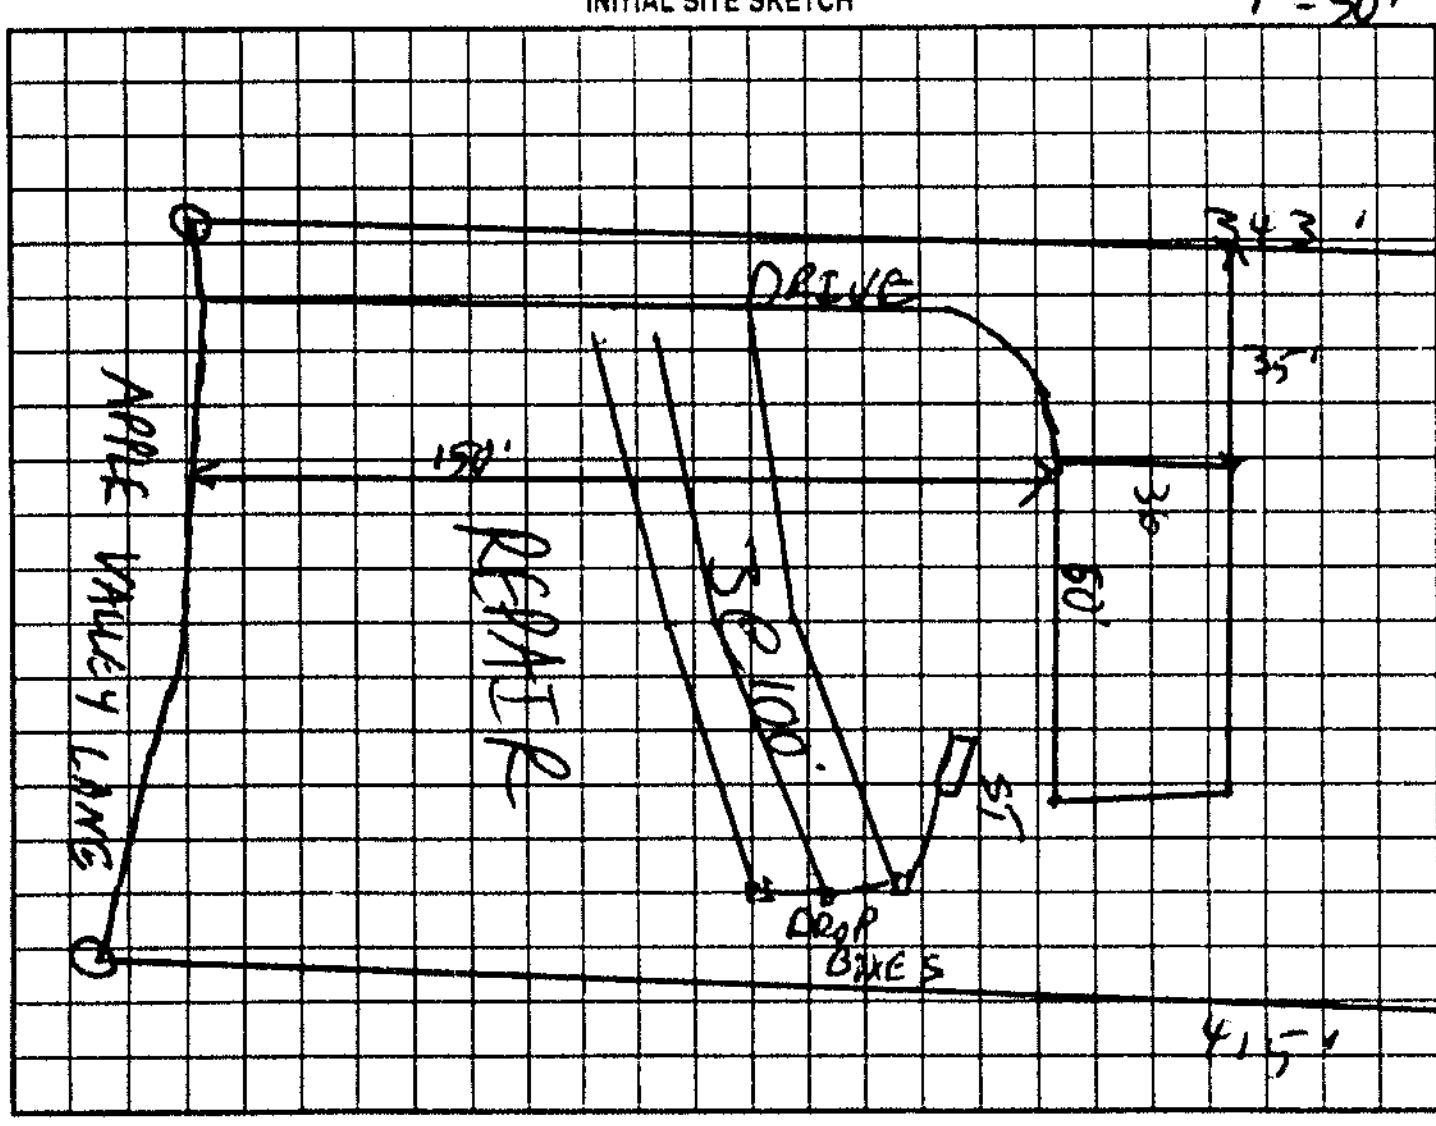

AS BUILT SKETCH

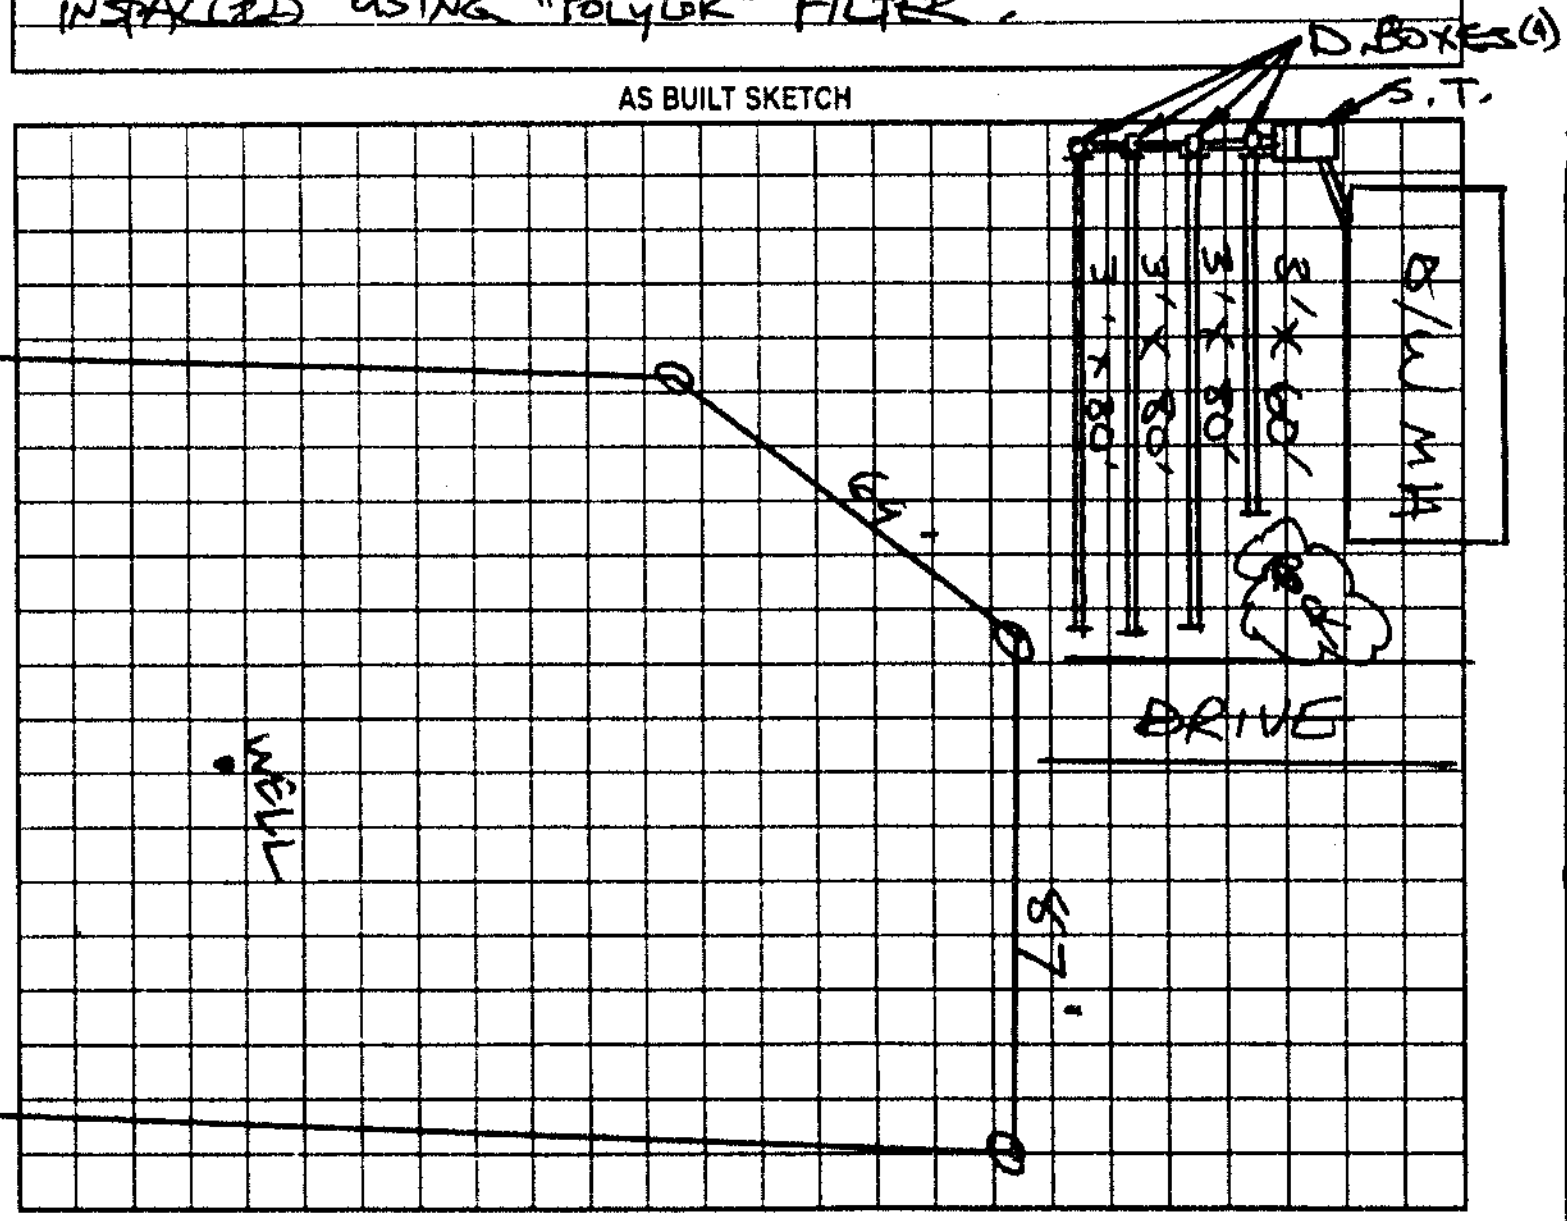

Permit can be suspended or revoked if any false information is supplied toward securing the permit/any unauthorized changes are made to the site/any unauthorized changes are made in the installation of the system. Improvement Permit with plat valid without expiration. Improvement Permit with site plan valid for sixty months. Authorization to Construct is valid for a period equal to that of Improvement Permit - not to exceed sixty months.

Signed: Jeff Casey agent date 4-5-00 Installed by: A-1 BACKHOE

Improvement Permit by: C. [illegible] RS date 4/4/00 Operation Permit by: STEVE HEDRICK date 9-12-00

Authorization to Construct by: STEVE HEDRICK date 9-12-00 Existing System Inspection by: date

HEALTH DEPT. COPY: WHITE OWNER COPY (FINAL): YELLOW OWNER COPY (INITIAL): PINK