THIS PERMIT REPLACES PREVIOUS ISSUED 5-17-2006 (1)

# IREDELL COUNTY HEALTH DEPARTMENT

STATESVILLE 704-878-5305 MOORESVILLE 704-664-5281

## IMPROVEMENT PERMIT / AUTHORIZATION TO CONSTRUCT / OPERATION PERMIT / EXISTING SYSTEM INSPECTION

PERMIT# 135818 PIN# 4743-10-6508 DATE 8-9-2006

OWNER OR APPLICANT FIRST CHOICE HOUSING, INC PHONE: Business 704-883-8228 Home

ADDRESS 119 BEECHNUT LANE, STATESVILLE, NC. 28677

LOCATION US21 S, TL MOOSE CLUB RD, TL SKYUKA RD, TR ARLIE, TR APPLE VALLEY, LOT ON RIGHT

SUBDIVISION APPLE VALLEY BLOCK / SECTION LOT 11 LOT AREA 2.218 ACRES SITE CLASS. PS DESIGN FLOW 360 L.T.A.R. 0.30 GPD/FT

Septic Tank: 1000 Gallons; STB 1007 Date 7-3-06
Pump Tank: Gallons; PT Date
Pump Make: Model Serial No.
Nitrification Field: No Fields 1 Square Feet EQ. P 1200 Linear Feet 300
No Lines FIVE Trench Width 36" Max Trench Bottom Depth 36" Gravel Depth N/A

☑ New System ☐ Repair ☐ Expansion System Type: I II III IV V VI
System Description: 25% REDUCTION, GRAVITY
Repair System Description: 50% REDUCTION LOW PRESSURE
Maintenance Agreement Required: ☐ Yes ☑ No
☑ Gravity ☐ Pressure


☐ House/Mod. Home ☐ Mobile Home ☐ Business ☐ Other
No. Bedrooms 3 No. Persons No. Employees
☐ Slab ☑ Crawl Space ☐ Basement w/plumbing ☐ Basement wo/plumbing

Water Supply: ☑ Individual ☐ Public ☐ Community WELL


Comments/Conditions: (1) INSTALL 25% REDUCTION SYSTEM ON CONTOUR AS FLAGGED. (2) NO FILL DIRT. ALLOWED OVER DRAINFIELD

Comments/Conditions: SEPTIC TANK WITH MARKER INSTALLED USING "BOWCO" FILTER

INITIAL SITE SKETCH

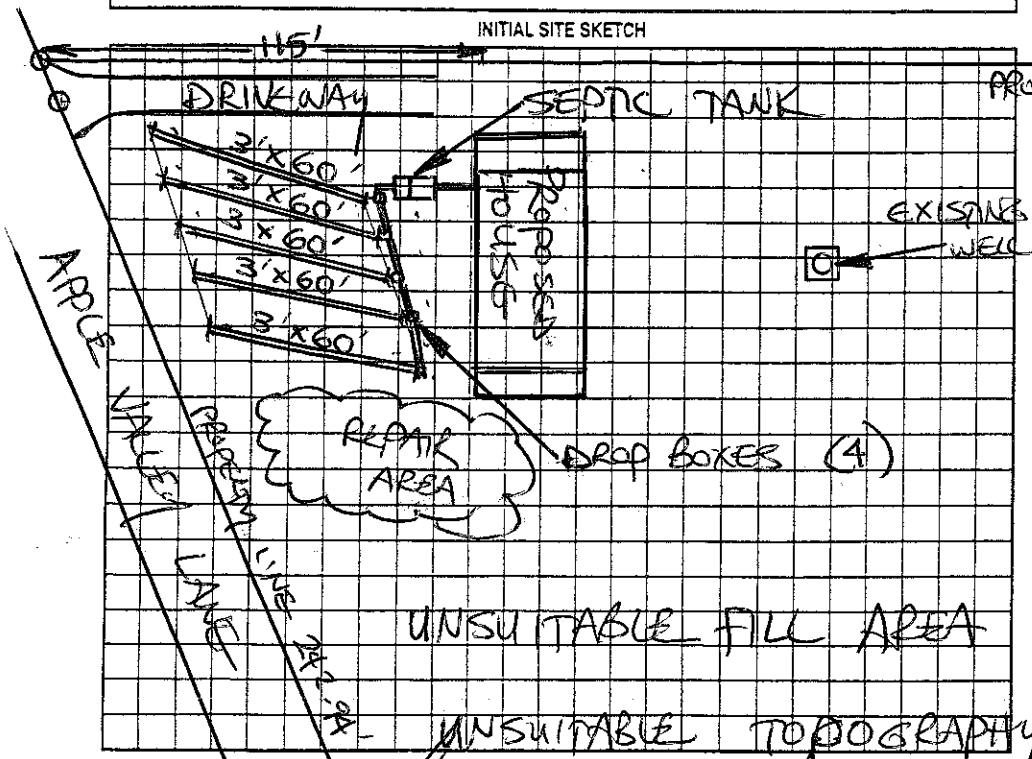


AS BUILT SKETCH

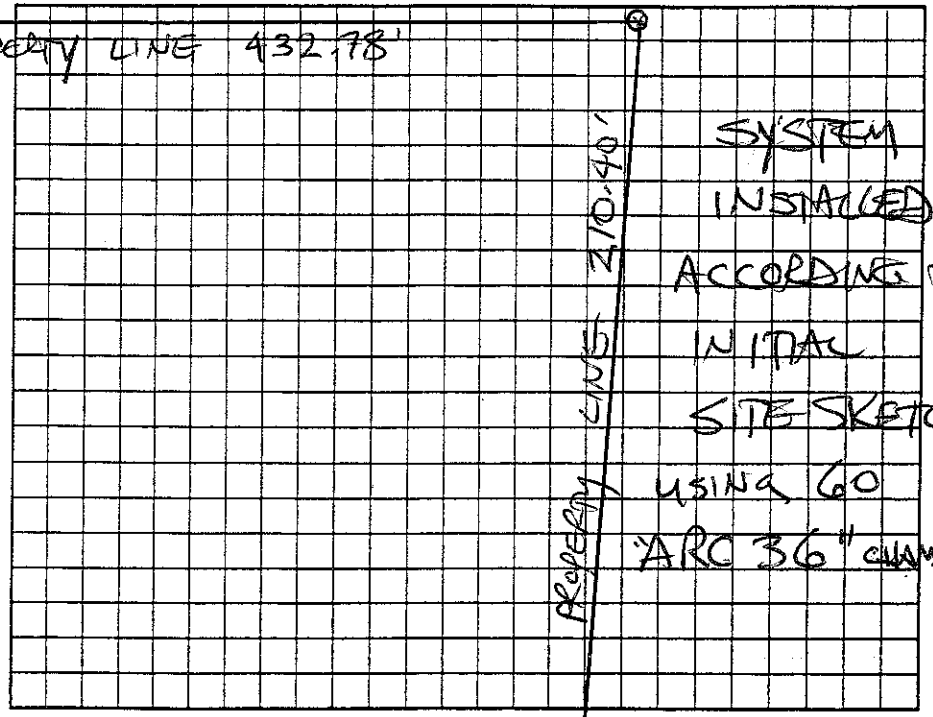


Permit can be suspended or revoked if any false information is supplied toward securing the permit/any unauthorized changes are made to the site/any unauthorized changes are made in the installation of the system. Improvement Permit with plat valid without expiration. ☐ Improvement Permit with site plan valid for sixty months ☑ Authorization to Construct is valid for a period equal to that of Improvement Permit – not to exceed sixty months.

Signed: date 8-10-06 Installed by: BOB'S BACKHOE

Improvement Permit by: STEVE HEDRICK date 8-9-06 Operation Permit by: STEVE HEDRICK date 8-15-06

Authorization to Construct by: STEVE HEDRICK date 8-9-06 Existing System Inspection by: date

HEALTH DEPT. COPY: WHITE OWNER COPY (FINAL): YELLOW OWNER COPY (INITIAL): PINK

DRAINAGE PATTERN