IREDELL COUNTY HEALTH DEPARTMENT

STATESVILLE 704-878-5305 125.00 MOORESVILLE 704-664-5281

IMPROVEMENT PERMIT / AUTHORIZATION TO CONSTRUCT / OPERATION PERMIT / EXISTING SYSTEM INSPECTION

PERMIT# 88680-3 PIN# 4743 10 58 47 PT DATE 4/4/00

OWNER OR CONTRACTOR FOX DEN ACRES PHONE. Business 567-9836 Home

ADDRESS 5201 MONROE RD CHARLOTTE NC 28205

LOCATION 21 S TL MOOSECLUB RD - TL SKYUKA - TR ARLIE LOOP TO APPLE VALLEY - 1ST ON LT

SUBDIVISION APPLE VALLEY BLOCK / SECTION LOT 36 LOT AREA .7 AC SITE CLASS 2S DESIGN FLOW 360 L.T.A.R. .36 gal/ft²

Septic Tank: 1000 Gallons; STB 312 Date 6-13-00
Pump Tank: Gallons; PT Date
Pump Make: Model Serial No
Nitrification Field: No Fields 1 Square Feet 900 Linear Feet 300
No Lines 4@75' Trench Width 36" Max Trench Bottom Depth 20"

☑ New System ☐ Repair System Type: I, II, (III), IV, V, VI
System Description: GRAVITY INNOVATIVE
Repair System Description: SAME
Maintenance Agreement Required: ☐ Yes ☑ No
Gravel Depth N/A ☐ Slab ☑ Crawl Space ☐ Basement w/plumbing ☐ Basement wo/plumbing


☐ House/Mod. Home No. Bedrooms 3
☑ Mobile Home No. Bathrooms 2
☐ Business No. Employees
☐ Other

Water Supply: ☑ Individual ☐ Public ☐ Community


Comments/Conditions: 1) KEEP WELL 100' FROM ANY SEPTIC SYSTEM 2) INSTALL INSPECTION PORTS IF SPECIAL 18" TRENCH BOTTOM CHAMBER IS USED.

Comments/Conditions: SEPTIC TANK WITH RISERS AND MARKER INSTALLED USING "ZABEL" FILTER

INITIAL SITE SKETCH 1"=50'

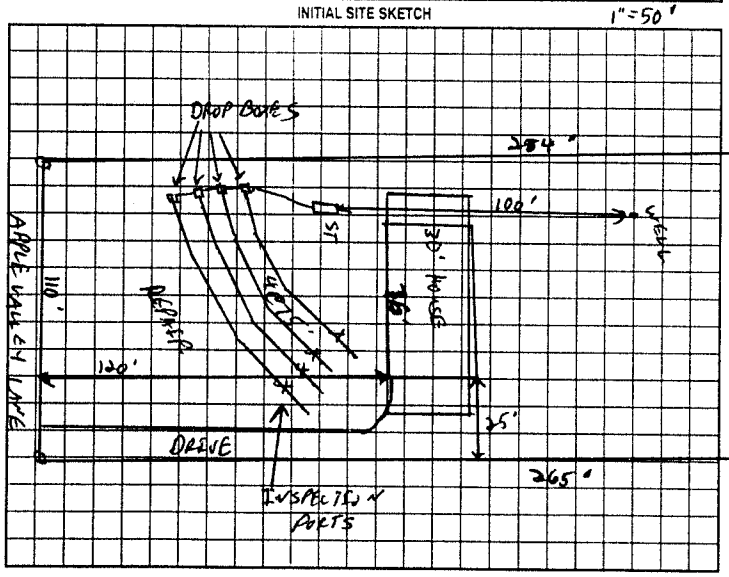

AS BUILT SKETCH

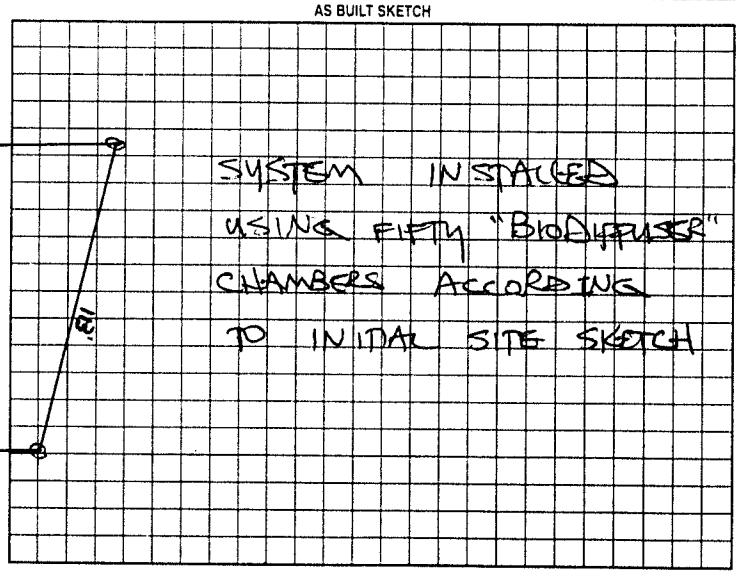

Permit can be suspended or revoked if any false information is supplied toward securing the permit/any unauthorized changes are made to the site/any unauthorized changes are made in the installation of the system. Improvement Permit with plat valid without expiration. Improvement Permit with site plan valid for sixty months. Authorization to Construct is valid for a period equal to that of Improvement Permit – not to exceed sixty months.

Signed: Jeff Casey Agent date 4-5-00

Improvement Permit by: [signature] RS date 4/4/00

Authorization to Construct by: STEVE HEDRICK date 5-22-00

Installed by: TUCKER'S HAULING & GRADING

Operation Permit by: STEVE HEDRICK date 7-20-2000

Existing System Inspection by: date

HEALTH DEPT COPY: WHITE OWNER COPY (FINAL): YELLOW OWNER COPY (INITIAL): PINK