FOR: MICHAEL HINSON

THIS PERMIT VOIDS PREVIOUS ISSUED 3-27-00

IREDELL COUNTY HEALTH DEPARTMENT

STATESVILLE 704-878-5305 MOORESVILLE 704-664-5281

IMPROVEMENT PERMIT / AUTHORIZATION TO CONSTRUCT / OPERATION PERMIT / EXISTING SYSTEM INSPECTION

PERMIT# 086799 PIN# 4743 10 5847 (PART) DATE 3-22-01

OWNER OR CONTRACTOR FOX DEN ACRES PHONE: Business (704) 567-9836 Home

ADDRESS 5201 MONROE ROAD, CHARLOTTE, NC 28205

LOCATION US 21 S, TL MOOSE CLUB, TL SKYUKA, TR ARLIE, CONTINUE APPLE VALLEY, LOT ON RIGHT AT BOYLER LN

SUBDIVISION APPLE VALLEY BLOCK / SECTION LOT 2 LOT AREA 0.73 ACRE SITE CLASS. PS DESIGN FLOW 360 L.T.A.R. 0.30 GPD/FT²

Septic Tank: 1000 Gallons: STB 794 Date 12/24/00

Pump Tank: Gallons; PT Date

Pump Make: Model Serial No.

Nitrification Field: No Fields 1 Square Feet 840 to 1200 Linear Feet 300+

No Lines FOUR Trench Width 36" Max Trench Bottom Depth 24" Gravel Depth N/A

☑ New System ☐ Repair System Type: I, II, III, IV, V, VI

System Description: 25% REDUCTION GRAVITY

Repair System Description: 25% REDUCTION GRAVITY

Maintenance Agreement Required: ☐ Yes ☒ No

☐ House/Mod. Home ☒ Mobile Home ☐ Business ☐ Other

No. Bedrooms 3 No. Bathrooms 2 No. Employees


☐ Slab ☒ Crawl Space ☐ Basement w/plumbing ☐ Basement wo/plumbing

Water Supply: ☒ Individual ☐ Public ☐ Community WELL


Comments/Conditions: ① KEEP SYSTEM MAXIMUM FEASIBLE DISTANCE (80') FROM WELL ② INSTALL 25% REDUCTION SYSTEM USING 50 CHAMBERS OR 30 HDS SECTIONS, ON CONTOUR AS FLAGGED

Comments/Conditions: ① NO CUTTING OR FILLING OVER DRAINFIELD/REPAIR AREAS ② KEEP ALL DRAINS AWAY FROM DRAINFIELD/REPAIR AREAS ③ PUMP SEPTIC TANK EVERY 3 5 YRS.

INITIAL SITE SKETCH

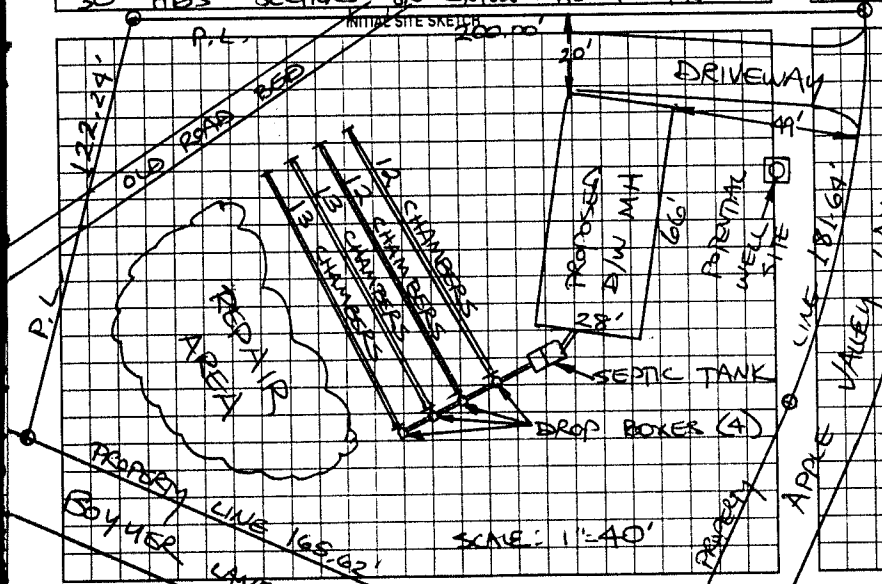

AS BUILT SKETCH

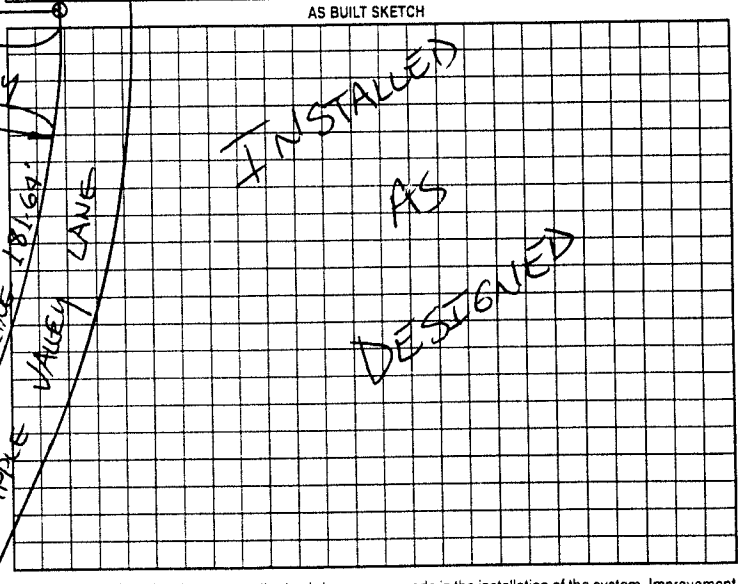

Permit can be suspended or revoked if any false information is supplied toward securing the permit, any unauthorized changes are made to the site/any unauthorized changes are made in the installation of the system. Improvement Permit with plat valid without expiration. Improvement Permit with site plan valid for sixty months. Authorization to Construct is valid for a period equal to that of Improvement Permit – not to exceed sixty months.

Signed: (Agent For Fox Den) date 3-26-01 Installed by: MARTY TUCKER

Improvement Permit by: STEVE HEDRICK date 3-22-01 Operation Permit by: date 4/2/01

Authorization to Construct by: STEVE HEDRICK date 3-22-01 Existing System Inspection by: date

HEALTH DEPT COPY WHITE OWNER COPY (FINAL) YELLOW OWNER COPY (INITIAL) PINK