IREDELL COUNTY HEALTH DEPARTMENT

STATESVILLE 704-878-5305 125.00 MOORESVILLE 704-664-5281

IMPROVEMENT PERMIT / AUTHORIZATION TO CONSTRUCT / OPERATION PERMIT / EXISTING SYSTEM INSPECTION

PERMIT# 86807 PIN# 4743105847 PT DATE 4/4/00

OWNER OR CONTRACTOR Fox Oen Acres PHONE: Business 567-9839 Home

ADDRESS 5001 Monroe Rd. Charlotte NC 28205

LOCATION 21S - TL Moose Club Rd. TL Skyuka. TL Allie Loop - To Apple Valley - on LT

SUBDIVISION Apple Valley BLOCK / SECTION LOT 32 LOT AREA 1.04AC SITE CLASS PS DESIGN FLOW 360gal L.T.A.R. .25gal/ft²

Septic Tank: 1000 Gallons: STB 825 Date 5-29-01
Pump Tank: 1000 Gallons: PT 302 Date 6-18-01
Pump Make: Zoeller Model N-98B Serial No. PN-98-0002
Nitrification Field: No Fields 1 Square Feet 960 Linear Feet 320
No Lines 3@100' Trench Width 36" Max Trench Bottom Depth 24" Gravel Depth N/A

☒ New System ☐ Repair System Type: I, II, III, IV, V, VI
System Description: Pump Innovative
Repair System Description: Same
Maintenance Agreement Required: ☐ Yes ☒ No
☐ Slab ☒ Crawl Space ☐ Basement w/plumbing ☐ Basement wo/plumbing


☐ House/Mod. Home No. Bedrooms 3
☒ Mobile Home No. Bathrooms 2
☐ Business No. Employees
☐ Other

Water Supply: ☒ Individual ☐ Public ☐ Community

Comments:/Conditions: 1) Keep well 100' from any septic system.

Comments:/Conditions: Septic tank with marker installed
Using "Poly Lok" filter
- Lines Installed using 3# HDS sections
- Pressure check Okay
- Electrical check Okay.

INITIAL SITE SKETCH 1"=100'

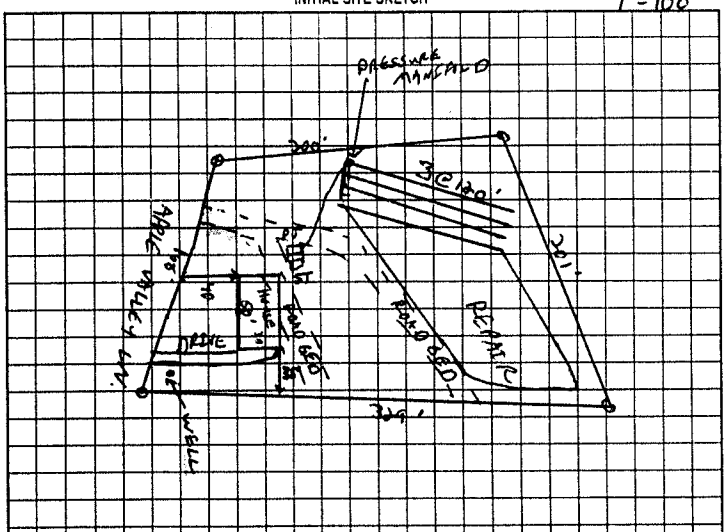

AS BUILT SKETCH

Installed as Shown per Initial Site Sketch

Permit can be suspended or revoked if any false information is supplied toward securing the permit/any unauthorized changes are made to the site/any unauthorized changes are made in the installation of the system. Improvement Permit with plat valid without expiration. Improvement Permit with site plan valid for sixty months. Authorization to Construct is valid for a period equal to that of Improvement Permit – not to exceed sixty months.

Signed: Jeff Casey agent date 4-5-00
Improvement Permit by: C. Ryan RS date 4/4/00
Authorization to Construct by: William G. Johnson date 5/30/01

Installed by: Bob's Backhoe
Operation Permit by: William G. Johnson date 10/10/01
Existing System Inspection by: date

HEALTH DEPT. COPY: WHITE OWNER COPY (FINAL): YELLOW OWNER COPY (INITIAL): PINK