IREDELL COUNTY HEALTH DEPARTMENT

Statesville Office (704) 878-5305 Mooresville Office (704) 660-3625 PERMIT # 222174

IMPROVEMENT PERMIT / AUTHORIZATION TO CONSTRUCT / OPERATION PERMIT / EXISTING SYSTEM

PIN # 4743114035

APPLICANT: 1st Choice Home Center APPLICANT ADDRESS: 119 Beechnut Ln Statesville NC

SITE ADDRESS: 105 Boyuer Ln Statesville NC 28677 PHONE: 704-883-8228 ALT. PHONE: N/A

SITE DIRECTIONS: 21S T/L Cumberland T/L Bluebird T/R Skyuka T/L Arlo Lp T/R Boyuer

SUBDIVISION: Apple Valley SECTION: 2 LOT # 8 LOT AREA: 0.657ac DESIGN FLOW: 360 L.T.A.R.: Ex


Septic Tank	Ex (gal)	STB		Date		☐ New System ☐ Repair ☐ Expansion	System Type: I II III IV V VI	☒ Residence	No. Bedrooms 3
Pump Tank	(gal)	PT		Date		System Description: Existing		☐ Business	No. Persons 6
Pump Make		Model		Serial #		Repair System Description:		☐ Other	No. Employees
# Nitrification Fields	Ex # Lines	Ex	Linear Ft:	Ex		Maintenance Agreement Required:	☐ YES ☒ NO	☐ Slab	☒ Crawl Space
Trench Width	Ex Max. Trench Bottom Depth	Ex	Gravel Depth			☒ GRAVITY	☐ PRESSURE	☐ Basement w/plumbing	☐ Basement w/o plumbing

Water Supply: ☒ Private ☐ Public ☐ Community

Comments / Conditions: All building foundations must be 53' from any part of STS and ≥25' from any well

INITIAL SITE SKETCH

AS BUILT SKETCH

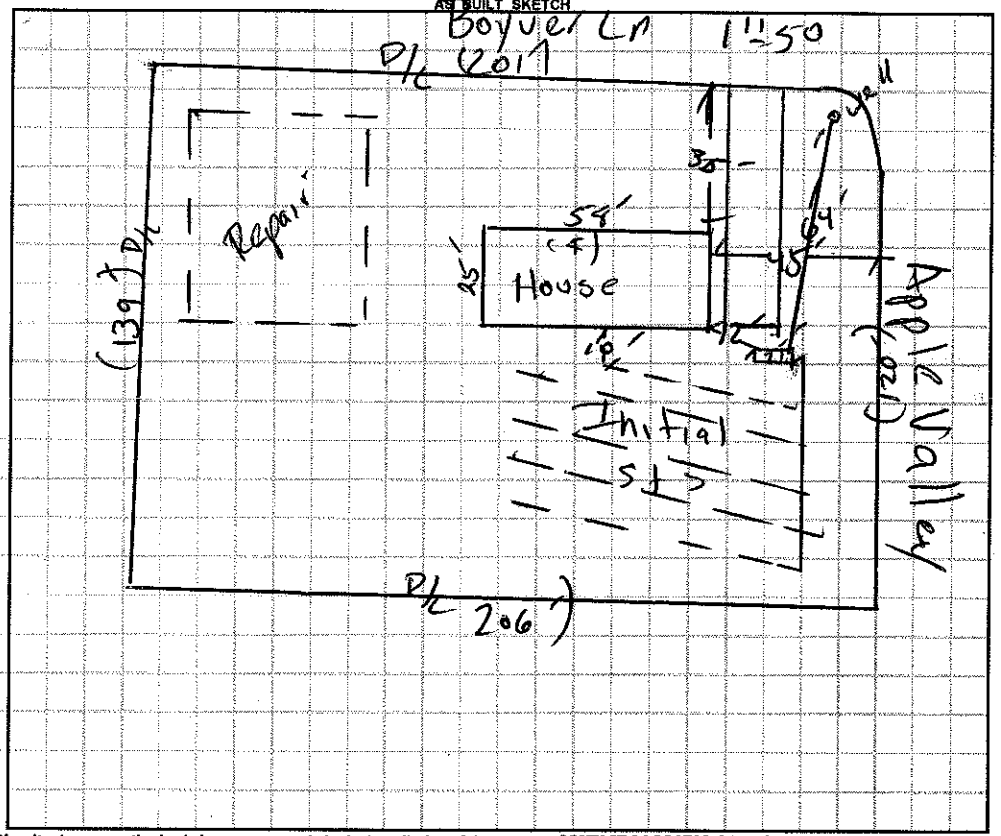

Permit can be suspended or revoked if any false information is supplied toward securing the permit / any unauthorized changes are made to the site / any unauthorized changes are made in the installation of the system. **CONTACT A LOCATOR SERVICE PRIOR TO ANY EXCAVATION**

☐ **IMPROVEMENT PERMIT** *with plat valid without expiration.* ☐ **IMPROVEMENT PERMIT** *with site plan valid for 60 mos.* ☐ **AUTHORIZATION TO CONSTRUCT** *valid for period equal to IMPROVEMENT PERMIT--not to exceed 60 mo.*

Owner / Applicant Signature: [signature] Date: 11-7-16 Installed by:

IMPROVEMENT PERMIT by: Date: OPERATION PERMIT by: Date:

AUTHORIZATION TO CONSTRUCT by: Date: Existing System Inspected by: [signature] Date: 11/4/16

Health Dept. Copy - WHITE Applicant (Final Approval) - YELLOW Applicant (Conditional Approval) - PINK