IREDELL COUNTY HEALTH DEPARTMENT

STATESVILLE 704-878-5305 125.00 MOORESVILLE 704-664-5281

IMPROVEMENT PERMIT / AUTHORIZATION TO CONSTRUCT / OPERATION PERMIT / EXISTING SYSTEM INSPECTION

PERMIT# 86806 PIN# 4743105847 PT DATE 4/4/00

OWNER OR CONTRACTOR FOX DEN ACRES PHONE: Business 567-9836 Home

ADDRESS 5001 MEN LEE RD CHARLOTTE NC 28205

LOCATION 215 - TL MOOSE CLUB RD - TL SKYUKA - TR ARLEE LOOP - TO APPLE VALLEY ON LT

SUBDIVISION APPLE VALLEY BLOCK / SECTION LOT 33 LOT AREA 6.59AC SITE CLASS PS DESIGN FLOW 360gpd L.T.A.R. 3gal/ft²

Septic Tank: 1000 Gallons: STB B 25 Date 3-4-01
Pump Tank: Gallons: PT Date
Pump Make: Model Serial No.
Nitrification Field: No Fields 1 Square Feet 900 Linear Feet 300
No Lines 4@75' Trench Width 36" Max Trench Bottom Depth 36" Gravel Depth

☒ New System ☐ Repair System Type: I, II, III, IV, V, VI
System Description: GRAVITY INNOVATIVE
Repair System Description: SAME
Maintenance Agreement Required: ☐ Yes ☒ No
☐ Slab ☒ Crawl Space ☐ Basement w/plumbing ☐ Basement wo/plumbing


☐ House/Mod. Home No. Bedrooms 3
☐ Mobile Home No. Bathrooms 2
☐ Business No. Employees
☐ Other

Water Supply: ☒ Individual ☐ Public ☐ Community


Comments/Conditions:

Comments/Conditions: SYSTEM INSTALLED AS SHOWN BELOW WITH POLYLOK FILTER & RISERS

INITIAL SITE SKETCH 1"=200'

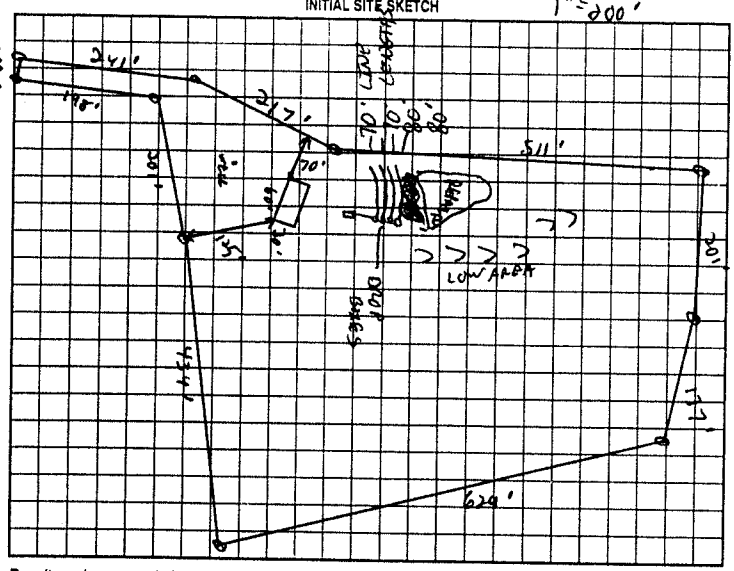

AS BUILT SKETCH

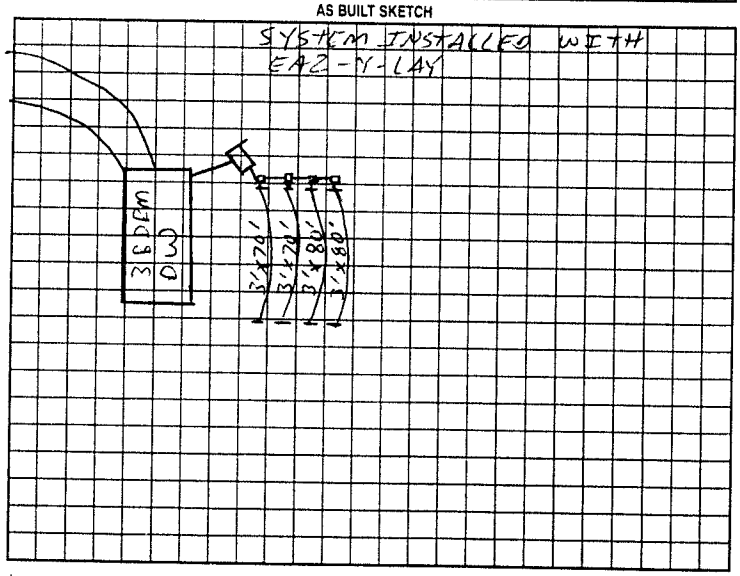

Permit can be suspended or revoked if any false information is supplied toward securing the permit/any unauthorized changes are made to the site/any unauthorized changes are made in the installation of the system. Improvement Permit with plat valid without expiration. Improvement Permit with site plan valid for sixty months. Authorization to Construct is valid for a period equal to that of Improvement Permit – not to exceed sixty months.

Signed: Jeff Cooley agent date 4-5-00

Improvement Permit by: RS date 4/4/00

Authorization to Construct by: date 4/12/01

Installed by: TODD UPRIGHT

Operation Permit by: Jim Cook REHS date 5-5-01

Existing System Inspection by: date

HEALTH DEPT. COPY: WHITE OWNER COPY (FINAL): YELLOW OWNER COPY (INITIAL): PINK