IREDELL COUNTY HEALTH DEPARTMENT

STATESVILLE 704-878-5305 MOORESVILLE 704-664-5281 (4)

IMPROVEMENT PERMIT / AUTHORIZATION TO CONSTRUCT / OPERATION PERMIT / EXISTING SYSTEM INSPECTION

PERMIT# 142431 PIN# 4743-11-6861 DATE 5-17-07

OWNER OR APPLICANT TEODORO GARCIA PHONE: Business 704-500-7703 Home

ADDRESS 129 APPLE VALLEY LANE, STATESVILLE NC 28677

LOCATION SKYUKA ROAD TO ARLIE LOOP CONTINUE APPLE VALLEY LANE, LOT ON LEFT AT #129

SUBDIVISION APPLE VALLEY BLOCK / SECTION LOT 33 LOT AREA 7.78 ACRES SITE CLASS PS1 DESIGN FLOW 240 L.T.A.R. 0.30 GPD/FT

Septic Tank: 1000 Gallons; STB Date

Pump Tank: Gallons; PT Date

Pump Make: Model Serial No.

Nitrification Field: No Fields 1 Square Feet EQUIT 1200 Linear Feet 300

No. Lines FOUR Trench Width 36" Max Trench Bottom Depth 36"

☐ New System ☐ Repair ☐ Expansion System Type: I II (III) IV V VI

System Description: 25% REDUCTION, GRAVITY

Repair System Description: 25% REDUCTION, GRAVITY

Maintenance Agreement Required: ☐ Yes ☒ No

☐ House/Mod. Home ☒ Mobile Home ☐ Business ☐ Other

No. Bedrooms 2 No. Persons No. Employees

Water Supply: ☒ Individual ☐ Public ☐ Community WELL

Gravel Depth N/A ☒ Gravity ☐ Pressure ☐ Slab ☐ Crawl Space ☐ Basement w/plumbing ☐ Basement wo/plumbing


Comments:/Conditions:

Comments:/Conditions:

INITIAL SITE SKETCH

AS BUILT SKETCH

SCALE: 1" = 100'

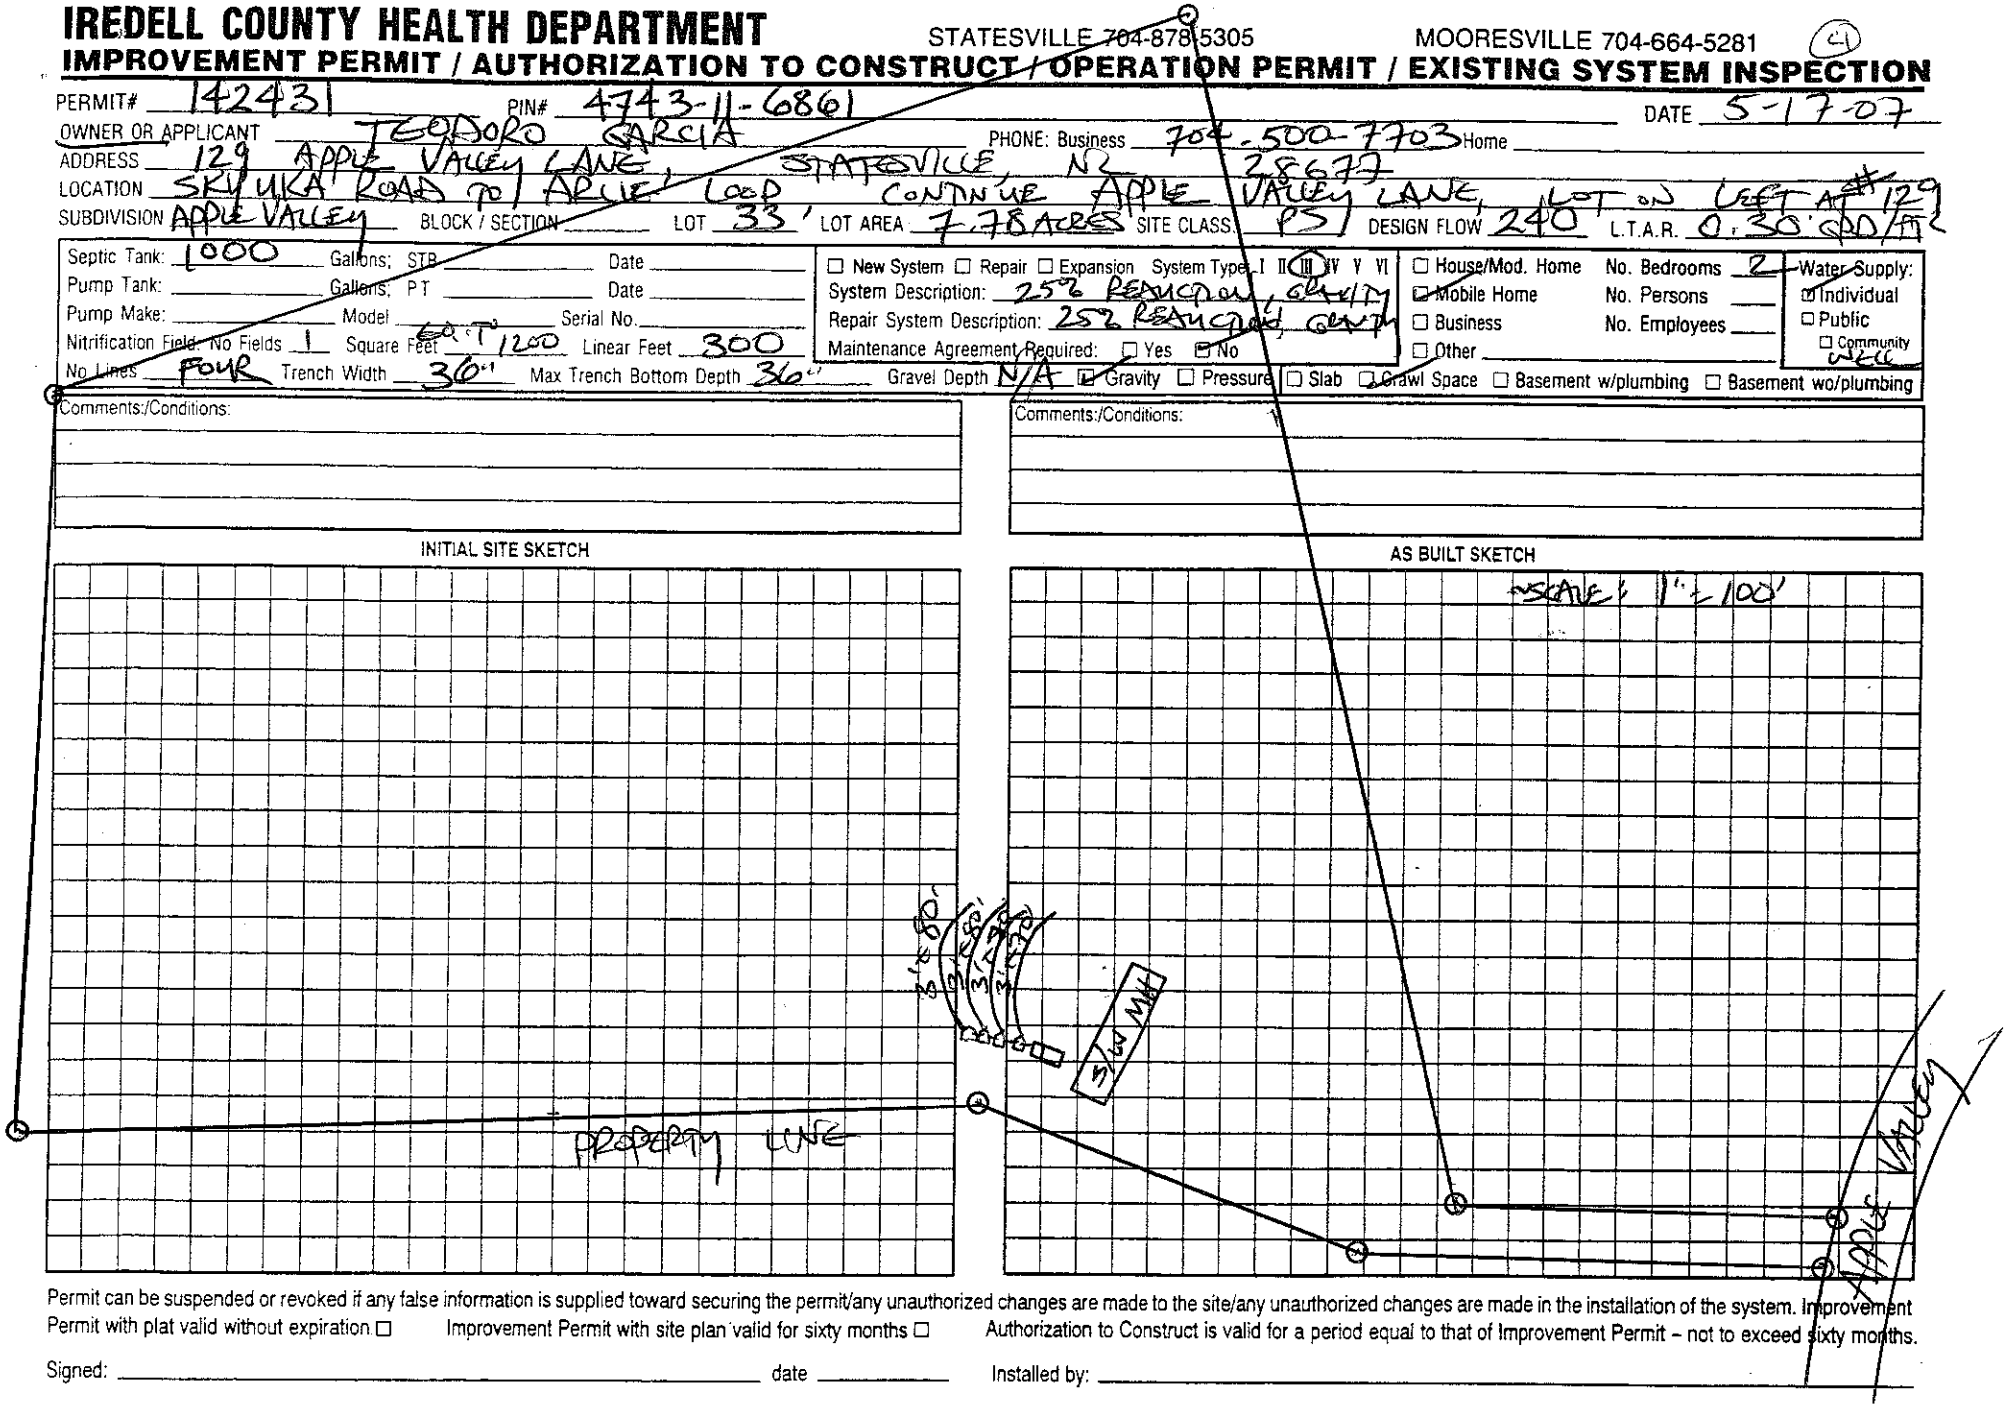

Permit can be suspended or revoked if any false information is supplied toward securing the permit/any unauthorized changes are made to the site/any unauthorized changes are made in the installation of the system. Improvement Permit with plat valid without expiration ☐ Improvement Permit with site plan valid for sixty months ☐ Authorization to Construct is valid for a period equal to that of Improvement Permit – not to exceed sixty months.

Signed: date Installed by:

Improvement Permit by: date Operation Permit by: date

Authorization to Construct by: date Existing System Inspection by: STEVE HENRICK date 5-17-07

HEALTH DEPT. COPY: WHITE OWNER COPY (FINAL): YELLOW OWNER COPY (INITIAL): PINK