ICHD - ENVIRONMENTAL HEALTH DIVISION

Statesville Office (704) 878-5305 | Mooresville Office (704) 660-3625 (BB)

PERMIT # OSWP-2022-6331

SEPTIC: IMPROVEMENT PERMIT / AUTHORIZATION TO CONSTRUCT / OPERATION PERMIT / EXISTING SYSTEM

PIN # 4743 -- 11 -- 8093

APPLICANT/OWNER: JILL BOOTH | APPLICANT ADDRESS: 159 APPLE VALLEY LANE, STATESVILLE, N.C 28677

SITE ADDRESS: 159 APPLE VALLEY LANE, STATESVILLE, N.C. 28677 | PHONE: 704-677-6709 | ALT. PHONE: –

SITE DIRECTIONS: (S) ON 21, (L) ON MOOSE CLUB, (L) ON SKYUKA, (R) ON ARLIE, (R) ON APPLE VALLEY, LOT ON (L) | SAP CONTROLLED: ☐ YES ☐ NO EXT

SUBDIVISION: APPLE VALLEY | SECTION: 3 | LOT # 28 | LOT AREA: 2.747 | DESIGN FLOW: EXT | L.T.A.R.: EXT


Septic Tank	EXT	(gal)	STB EXT	Date	EXT	☐ New System ☐ Repair ☐ Expansion	System Type: I (II) III IV V VI	☑ Residence	No. Bedrooms 3
Pump Tank	–	(gal)	PT –	Date	–	System Description:	EXISTING - CONVENTIONAL	☐ Business	No. Persons 6
Pump Make	–	Model	–	Serial #	–	Repair System Description:	EXT	☐ Other	No. Employees –
# Nitrification Fields	EXT	# Lines	EXT	Linear Ft	EXT	Maintenance Agreement Required:	☐ YES ☑ NO	☐ Slab	☑ Crawl Space
Trench Width	EXT	Trench Bottom Depth(Low side)	EXT	Gravel Depth	EXT	☑ GRAVITY	☐ PRESSURE	☐ Basement w/plumbing	☐ Basement w/o plumbing

Water Supply: ☑ Private EXT ☐ Public ☐ Community

Comments / Conditions: SYSTEM APPEARED TO BE FUNCTIONING AT TIME OF INSPECTION, WATERS EDGE of POOL MUST BE 15ft FROM ALL PARTS OF SEPTIC


RECOMMEND REMOVING DECK BUILT OVER TANK AND DRAINLINES

INITIAL SITE SKETCH

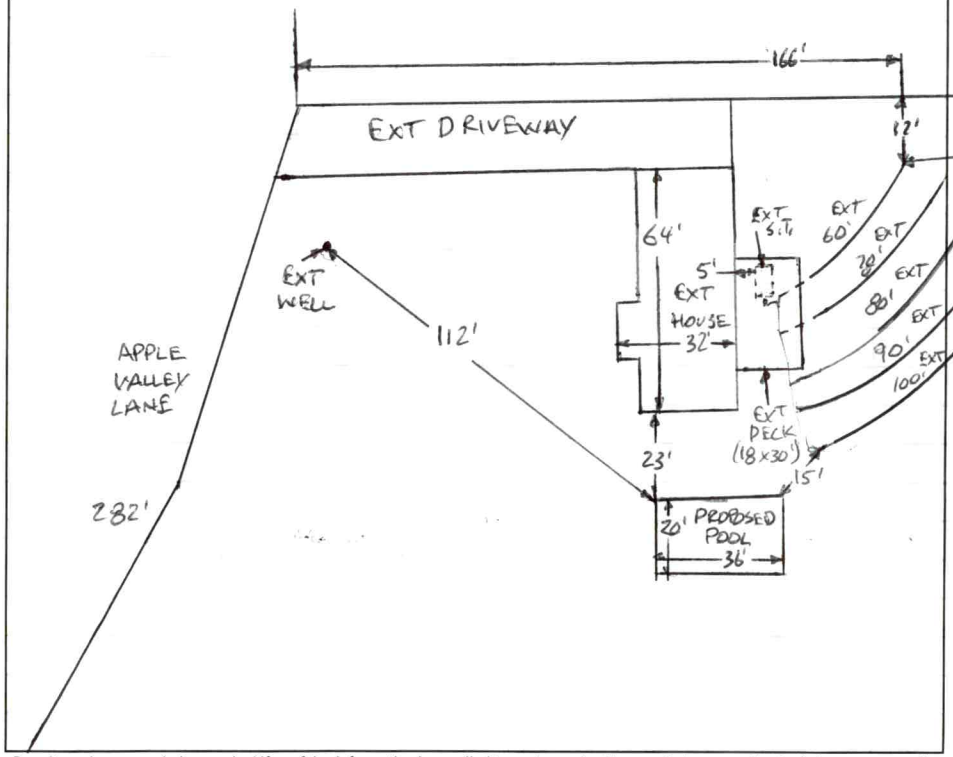

AS BUILT SKETCH

FOR SEPTIC FINAL INSPECTION CALL: 704-664-3703 between 8am-9am the day the inspection is needed. Be sure to speak with an inspector to confirm your time.

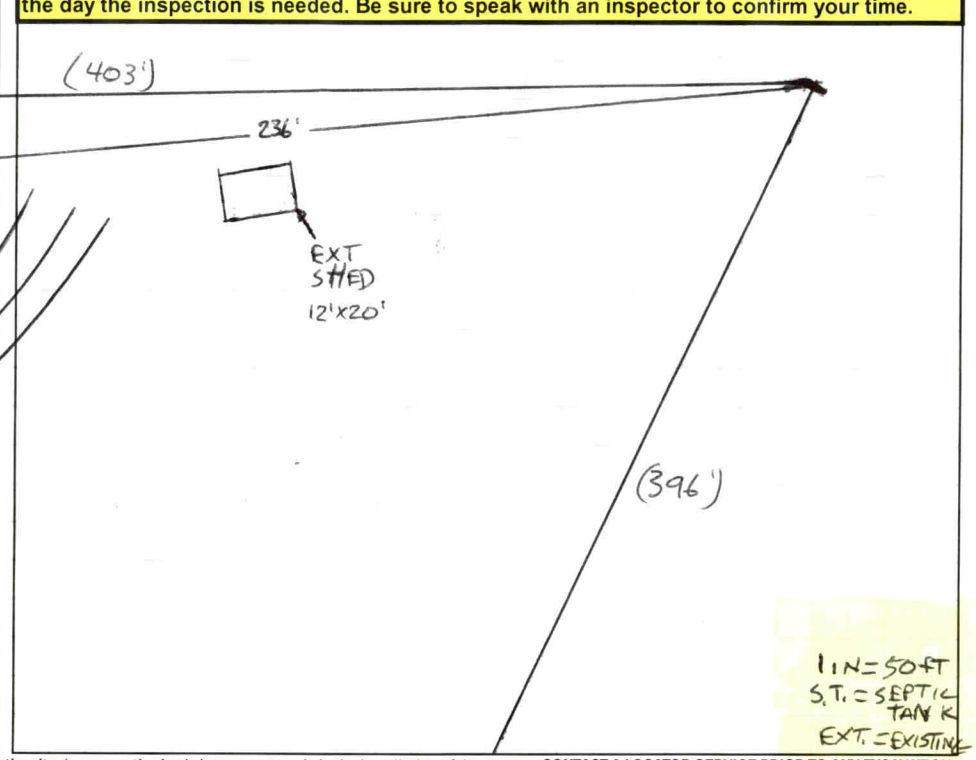

Permit can be suspended or revoked if any false information is supplied toward securing the permit / any unauthorized changes are made to the site / any unauthorized changes are made in the installation of the system. **CONTACT A LOCATOR SERVICE PRIOR TO ANY EXCAVATION**

☐ **IMPROVEMENT PERMIT** ***with plat*** *valid without expiration.* ☐ **IMPROVEMENT PERMIT** ***with site plan*** *valid for 60 mos.* ☐ **AUTHORIZATION TO CONSTRUCT** *valid for period equal to IMPROVEMENT PERMIT--not to exceed 60 mo.*

Owner / Applicant Signature: _____ Date: _____ Installed by: _____

IMPROVEMENT PERMIT by: _____ Date: _____ OPERATION PERMIT by: _____ Date: _____

AUTHORIZATION TO CONSTRUCT by: _____ Date: _____ Existing System Inspected by: Bryant C. Watts Date: 12-14-2022

FOR SEPTIC FINAL INSPECTION: CALL 704-664-3703 between 8am-9am the day the inspection is needed.

Item	Date	Initials
Drain Lines Checked		
Tanks Checked		
Pressure Manifold or Valve Box Checked		
Pressure Head Set		
Electrical Checked		
Floats Set		
Alarm Checked		
Maintenance Contract Needed? Y / N		
Comments:		

Repairs Only	
	State Code
Failing System Code	
Type of Distribution	G or P
Type of Failure/Malfunction	
Primary Cause of Failure/Malfunction	
Age of System? _____	
Initial or Repair? _____	

IREDELL COUNTY HEALTH DEPARTMENT

STATESVILLE 704-878-5305 100.00 MOORESVILLE 704-664-5281

IMPROVEMENT PERMIT / AUTHORIZATION TO CONSTRUCT / OPERATION PERMIT / EXISTING SYSTEM INSPECTION

PERMIT# 073754 PIN# 4743 05847 DATE Sept. 1, 198

OWNER OR CONTRACTOR For Her Acres Inc. PHONE: Business 567-9856 Home

ADDRESS 5201 Mooring St. Chandler 28205

LOCATION Beaver Club Rd. TL Brindle Rd. TR Arbie Loop - 2 stony left to Apple Valley Lane - on left

SUBDIVISION Apple Valley BLOCK / SECTION LOT 28 LOT AREA 2.74 ac SITE CLASS PS DESIGN FLOW 360 gpd L.T.A.R. .3

Septic Tank: 1000 Gallons: STB 1612 Date 1-24-98
Pump Tank: Gallons: PT Date
Pump Make: Model Serial No.
Nitrification Field: No Fields 1 Square Feet 1200 Linear Feet 400
No Lines 4 Trench Width 36" Max Trench Bottom Depth 36"

[X] New System [ ] Repair System Type: I, II, III, IV, V, VI
System Description: gravity conventional
Repair System Description: same
Maintenance Agreement Required: [ ] Yes [X] No

[ ] House/Mod. Home No. Bedrooms 3
[X] Mobile Home No. Bathrooms 2
[ ] Business No. Employees
[ ] Other

[ ] Slab [X] Crawl Space [ ] Basement w/plumbing [ ] Basement wo/plumbing


Water Supply: [X] Individual [ ] Public [ ] Community

Comments:/Conditions:


Comments:/Conditions:

1" = 100'

INITIAL SITE SKETCH

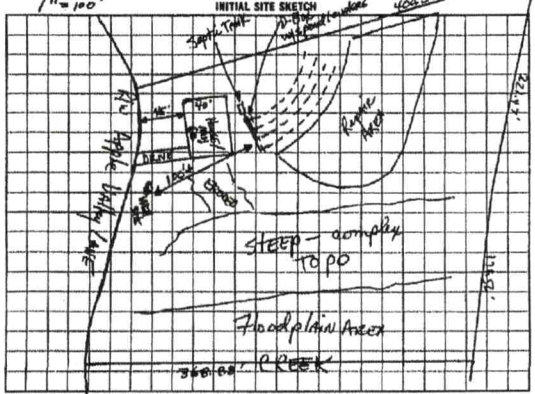

AS BUILT SKETCH

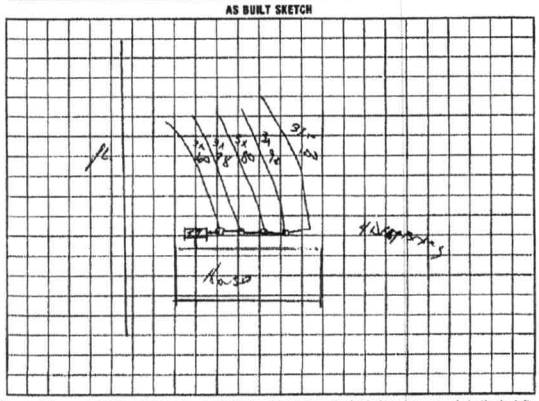


I understand that this permit can be suspended or revoked if any false information is supplied toward securing the permit/any unauthorized changes are made to the site/any unauthorized changes are made in the installation of the system. Improvement Permit with plat valid without expiration. Improvement Permit with site plan valid for sixty months. Authorization to Construct is valid for a period equal to that of Improvement Permit – not to exceed sixty months.

Signed: Jeff Cook Agent date 4-5-00 Installed by: M Brothers

Improvement Permit by: David Sechrest REHS date 9-1-98 Operation Permit by: J.C. Potter date May 23 2000

Authorization to Construct by: J.C. Potter date 9/21/98 Existing System Inspection by: date

HEALTH DEPT. COPY: WHITE INSPECTION COPY (FINAL): GREEN OWNER COPY (FINAL): YELLOW INSPECTION COPY (INITIAL): PINK OWNER COPY (INITIAL): GOLD

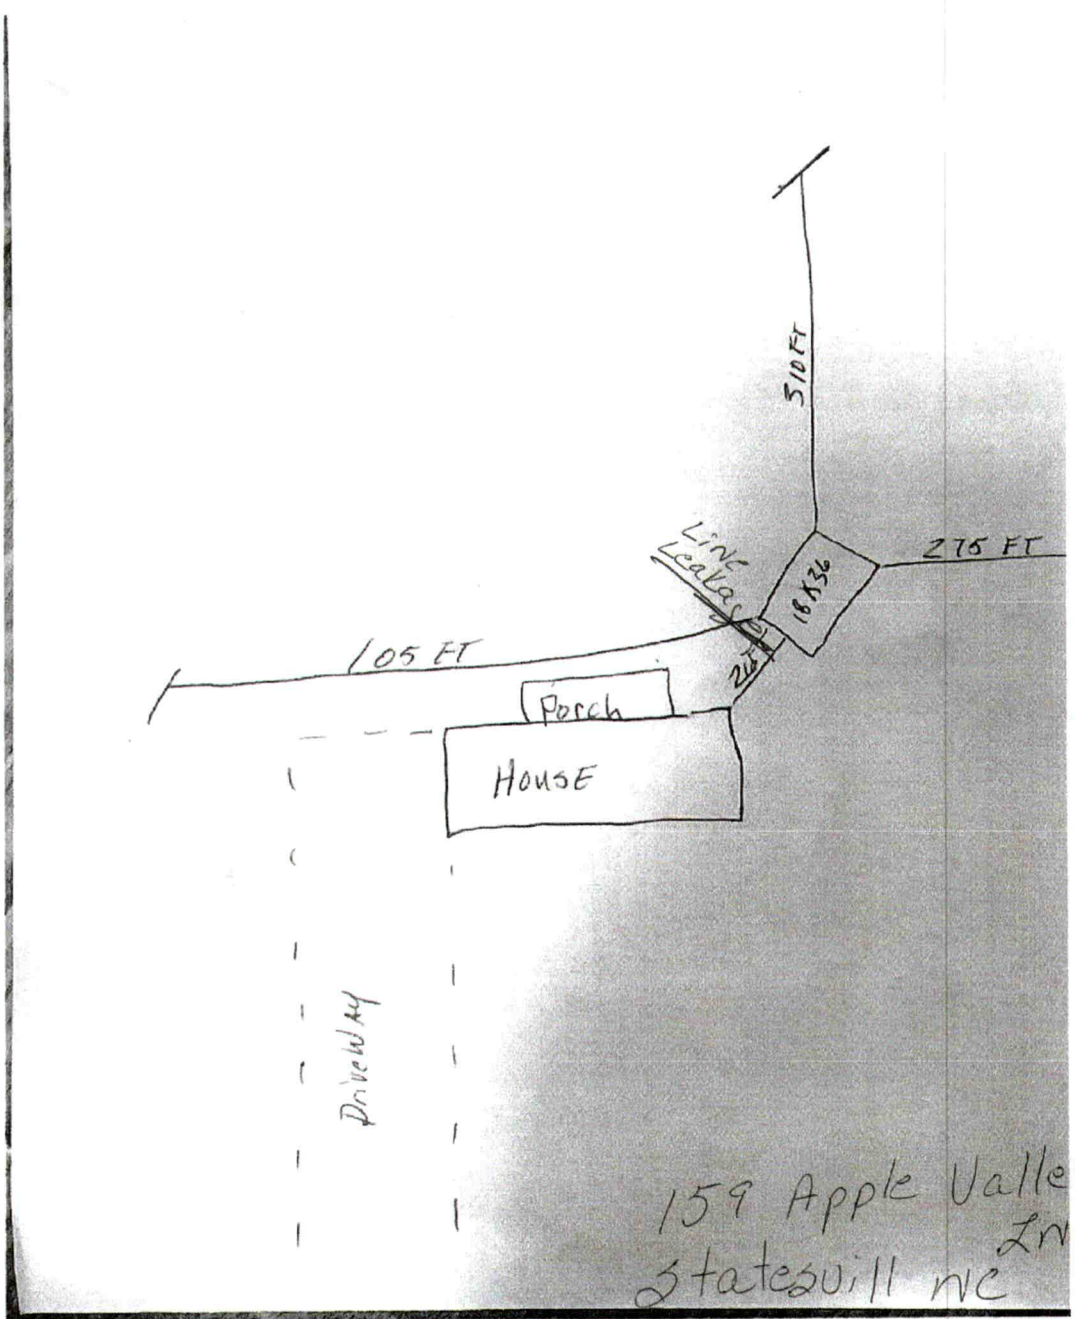

POOL-2022-1141

Jill Booth

IREDELL COUNTY HEALTH DEPARTMENT

STATESVILLE 704-878-5305 100.00 MOORESVILLE 704-664-5281

IMPROVEMENT PERMIT / AUTHORIZATION TO CONSTRUCT / OPERATION PERMIT / EXISTING SYSTEM INSPECTION

PERMIT# 073754 PIN# 4743 05847 DATE Sept. 1, 198

OWNER OR CONTRACTOR For New Homes Inc. PHONE: Business 567-9836 Home

ADDRESS 5201 Mayers St. Charlotte 28205

LOCATION Mount Ulla Rd. TL Statesville Rd. TR Oakview Loop - 3 Story left to Apple Valley Lane - 2nd left

SUBDIVISION Apple Valley BLOCK / SECTION LOT 28 LOT AREA 2.740ac SITE CLASS. PS DESIGN FLOW 360gpd L.T.A.R. .3

Septic Tank: 1000 Gallons; STB 1012 Date 1-24-00
Pump Tank: Gallons; PT Date
Pump Make: Model Serial No.
Nitrification Field: No Fields 1 Square Feet 1200 Linear Feet 400
No Lines 4 Trench Width 36" Max Trench Bottom Depth 36" Gravel Depth 12"

[x] New System [ ] Repair System Type: I, II, III, IV, V, VI
System Description: gravity conventional
Repair System Description: Same
Maintenance Agreement Required: [ ] Yes [x] No
[ ] Slab [x] Crawl Space [ ] Basement w/plumbing [ ] Basement wo/plumbing

[x] House/Mod. Home No. Bedrooms 3
[ ] Mobile Home No. Bathrooms 2
[ ] Business No. Employees
[ ] Other


Water Supply: [x] Individual [ ] Public [ ] Community

Comments/Conditions:


Comments/Conditions:

1" = 100'

INITIAL SITE SKETCH

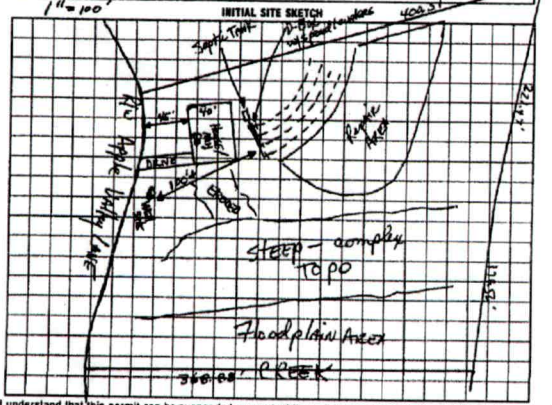

AS BUILT SKETCH

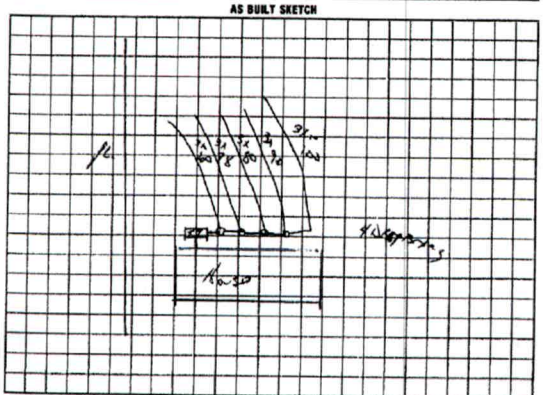


I understand that this permit can be suspended or revoked if any false information is supplied toward securing the permit/any unauthorized changes are made to the site/any unauthorized changes are made in the installation of the system. Improvement Permit with plat valid without expiration. Improvement Permit with site plan valid for sixty months. Authorization to Construct is valid for a period equal to that of Improvement Permit – not to exceed sixty months.

Signed: Jeff Gray Agent date 4-5-00
Improvement Permit by: [illegible] date 9-1-98
Authorization to Construct by: J. Potter date 9/21/9-23-98 Existing System Inspection by:

Installed by: M Brickhouse
Operation Permit by: J. Potter date May 23 2000
date

HEALTH DEPT. COPY: WHITE INSPECTION COPY (FINAL): GREEN OWNER COPY (FINAL): YELLOW INSPECTION COPY (INITIAL): PINK OWNER COPY (INITIAL): GOLD

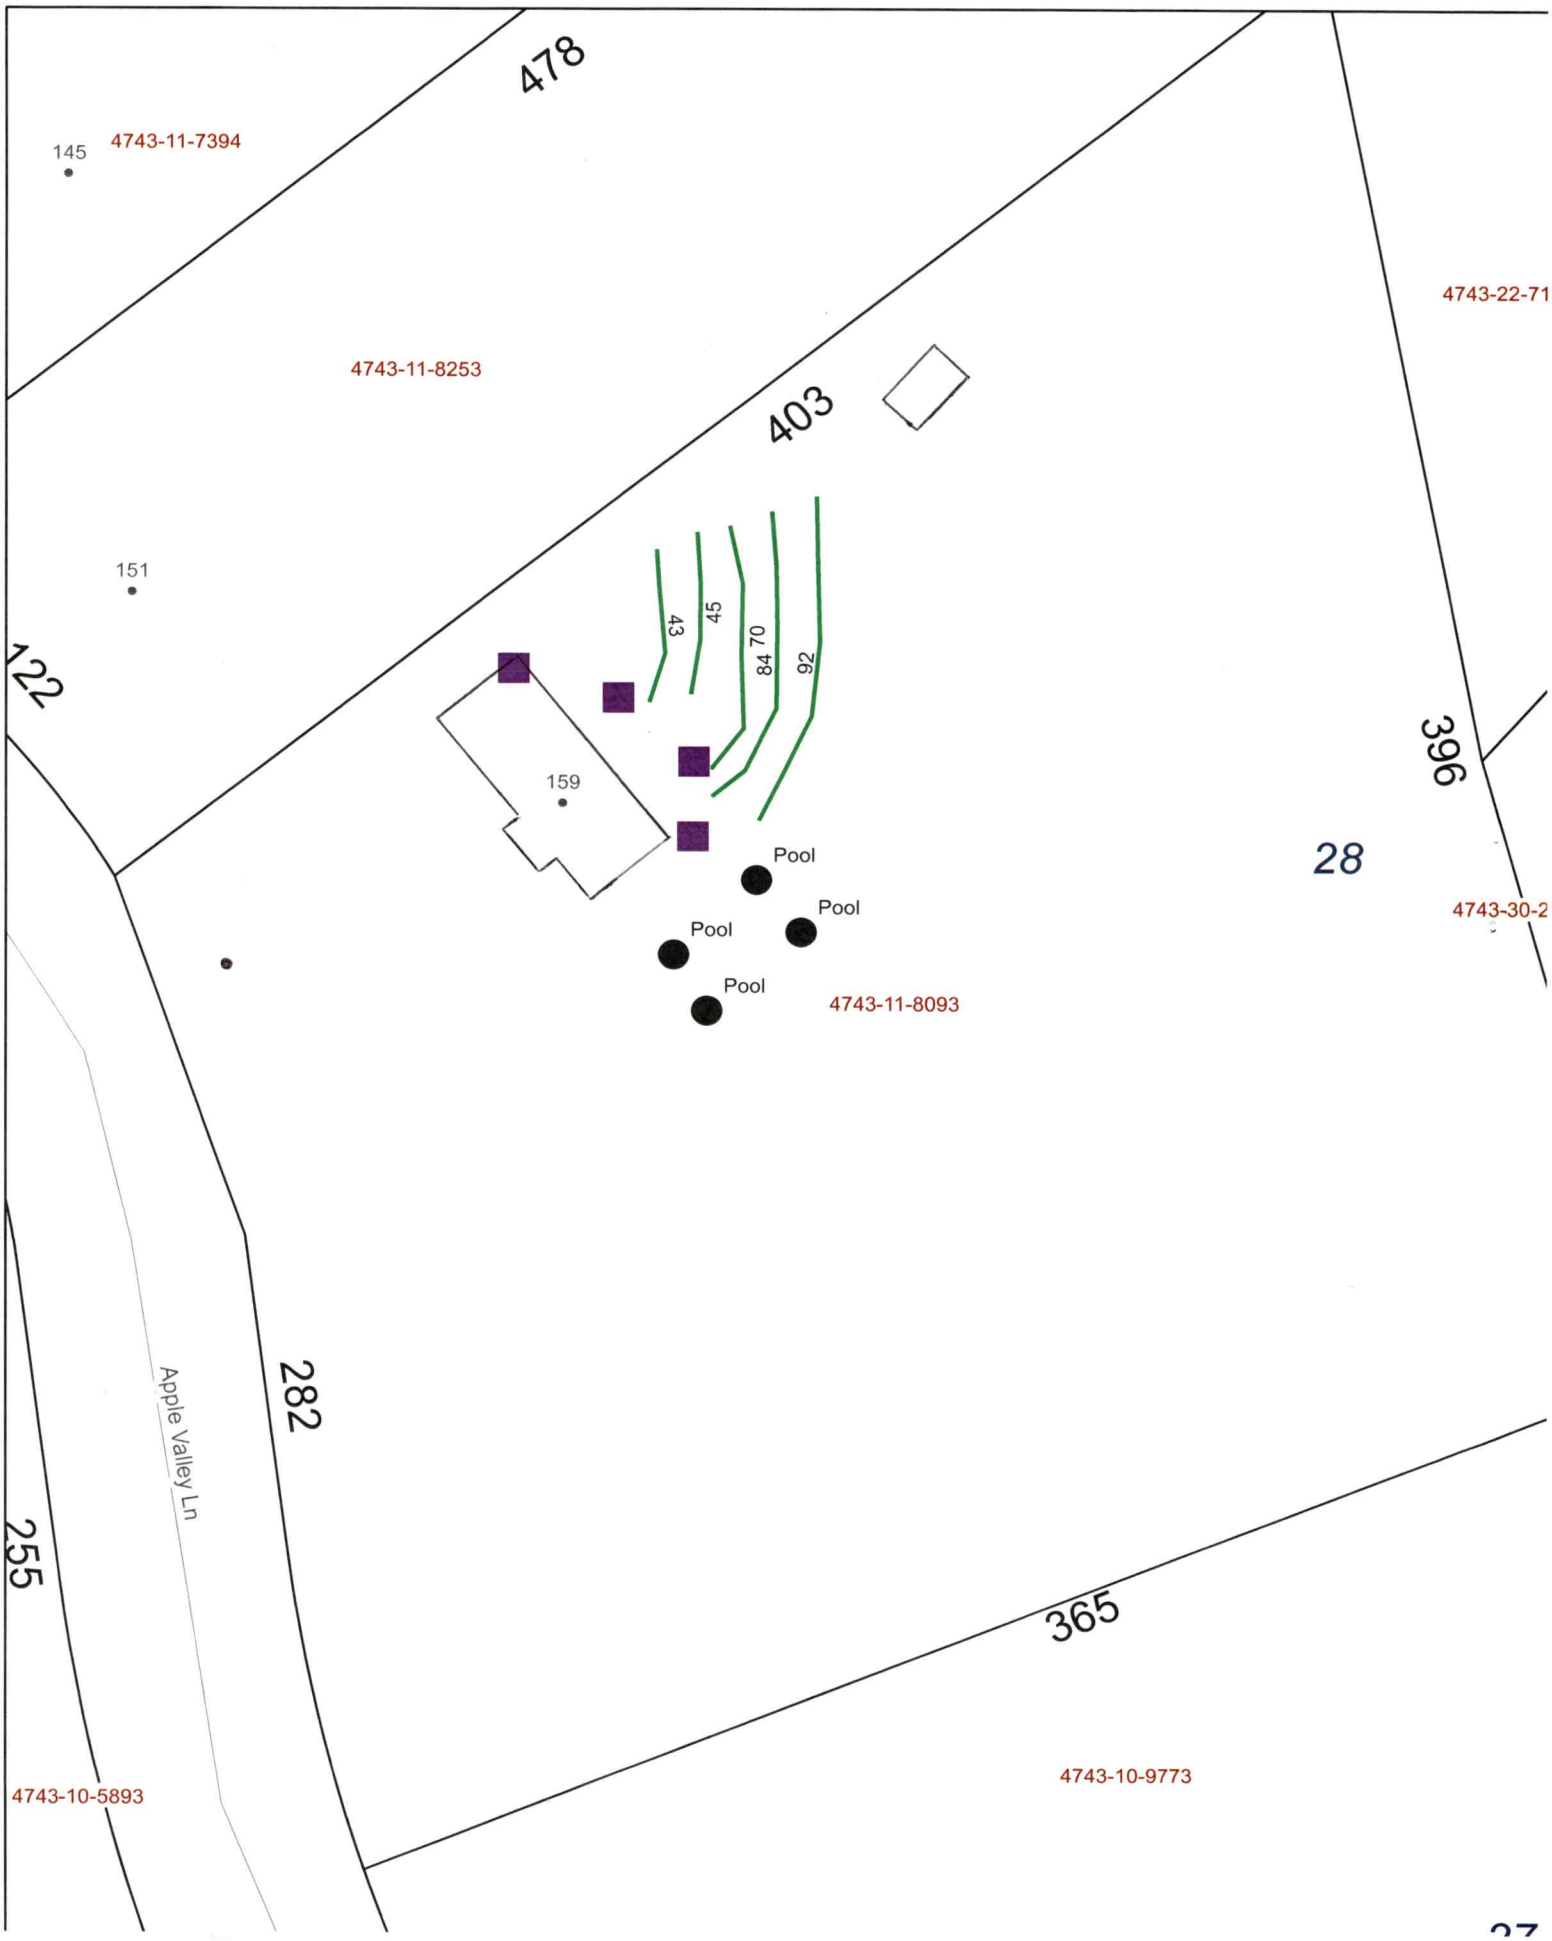
478
145
4743-11-7394
4743-22-71
4743-11-8253
403
151
122
43
45
70
84
92
159
396
Pool
Pool
Pool
Pool
28
4743-30-2
4743-11-8093
282
Apple Valley Ln
255
365
4743-10-5893
4743-10-9773



Tax Map Information

• PIN	4743118093.000
• Address	159 APPLE VALLEY LN
• Account #	Acct 80018990
• Tax Owner	BOOTH JILL
• Mailing Address	159 APPLE VALLEY LN
•	STATESVILLE, NC 28677
• GIS Owner	BOOTH JILL
• Deed Info	2322 / 1117 - WD - 20141009
• Tax Acres	2.747 AC
• Lot #	28
• Description	APPLE VALLEY SHT3 PB35-13-15
• Zoning	RA
• Old Parcel #	
• Bldg Value	$59,940
• OBXF Value	$2,920
• Land Value	$27,000
• Total Value	$89,860
• Defer Value	$0
• Tax Districts	-ALLCNTY FIRE- -

IREDELL COUNTY, NC

MAP FOR REFERENCE ONLY
NOT A LEGAL DOCUMENT

Iredell County, North Carolina makes no claims and no warranties, expressed or implied, concerning the validity or accuracy of the GIS data presented on this map.

Print map scale is approximate. Critical layout or measurement activities should not be done using this resource.

removed, or when NOT in use have a gate to the ladder as described above. SETBACK TO STRUCTURE COULD BE MORE OR LESS DEPENDING UPON THE BUILDING CODE; HOWEVER THERE IS A ? FT SET BACK FROM THE PROPERTY LINE.*The setback could change depending on the structure and size of the structure.

Attachment File Name	Added On	Added By	Attachment Group	Notes
Signature_Jill_Booth_10/6/2022.jpg	10/06/2022 14:18	Booth, Jill		Uploaded via CSS
apple valley owner auth_v1.pdf	10/06/2022 14:43	Hart, Ronda	Available Online	Authorize to Act as Agent
apple valley site plan_v1.pdf	10/06/2022 14:43	Hart, Ronda	Available Online	Site Plan

Inspection Number	Status	Inspection Type	Request Date	Scheduled Start Date	Scheduled End Date	Actual Start Date	Actual End Date
2022-34781	Passed - Permit	OSWP Septic/Well Preliminary Site Visit	11/09/2022			11/09/2022 8:18	11/09/2022 8:18

Inspectors: Kobuck, Teanna (Primary)

Checklist Item	Description	Passed	Comments
General Comments	Checklist item used to track general comments, not specific to any other checklist item	No	

Invoice No.	Fee	Fee Amount	Amount Paid
INV-00003250	New Gravity System	$500.00	$500.00
	Total for Invoice INV-00003250	$500.00	$500.00
	Grand Total for Permit	**$500.00**	**$500.00**

Workflow Step / Action Name	Action Type	Start Date	End Date
Application Completeness Check v.1		10/06/2022 0:00	10/06/2022 14:44
Confirm application complete v.1	Generic Action		10/06/2022 14:44
~~**Zoning Review v.1**~~			10/06/2022 14:44
~~Iredell County Zoning Approval v.1~~	Task		10/06/2022 14:44
~~Issue Invoice v.1~~	Generic Action		10/06/2022 14:44
~~Fees Paid v.1~~	Generic Action		10/06/2022 14:44
Fees v.1		10/06/2022 0:00	10/11/2022 15:59
Issue Invoice v.1	Generic Action		10/06/2022 14:44
Fees Paid v.1	Generic Action		10/11/2022 15:59
Lot Readiness Verification v.1		11/10/2022 0:00	
OSWP Septic Preliminary Site Visit v.1	Inspection	11/10/2022 0:00	11/10/2022 8:19
OSWP Site Evaluation v.1	Inspection		
Issue Improvement Permit v.1			
Issue Invoice v.1	Generic Action		
Fees Paid v.1	Generic Action		
Issue Permit v.1	Generic Action		
Permit Completion Process v.1			
Authorization to Construct Permit v.1	Create Sub Permit		
Issue Authorization to Construct v.1	Generic Action		

PERMIT SNAPSHOT REPORT OSWP-2022-6331 FOR IREDELL COUNTY

Permit Type	Environmental Health OSWP	**Project:**		**App Date:**	10/06/2022
Work Class:	EH Septic Relocation Improvement Permit	**District:**	Iredell County	**Exp Date:**	NOT AVAILABLE
Status:	In Progress	**Square Feet:**	0.00	**Completed:**	NOT COMPLETED
Valuation:	$0.00	**Assigned To:**	White, Bryant	**Approval Expire Date:**	

Description: **EHS Please Call Applicant** RELOCATION - DUG POOL TOO CLOSE TO LINE leaking line - Lentz relocate lines asap to continue POOL-2022-1141 zoning done on the pool

Parcel: 4743118093.000 Main	**Address:** 159 Apple Valley Ln Statesville, NC 28677 Main	**Zone:** RA(Residential Agricultural District)

Applicant/Authorized Agent	Property Owner
Jill Booth	Jill Booth
159 Apple Valley Ln	159 Apple Valley Ln
Statesville, NC 28677	Statesville, NC 28677
Mobile: (704) 677-6709	Mobile: (704) 677-6709

Permit Custom Fields

How is your site plan being submitted	Custom Site Plan	Does the site contain any jurisdictional wetlands	Yes	Non-domestic Sewage Generated	No
Other Public Agency	No	All proposed structure dimensions	18x36 inground pool	What are the proposed structures	Swimming Pool
If other Addition/Structure, please explain		Maximum Number of Bedrooms	3	Number of Occupants	3
Foundation Type	Crawl Space Foundation	Residential/Business/Other	Residential	Number of Employees	0
Total number of seats	0	Water Supply	Existing Well	Desired Septic System Type	Other
If other septic system type, please explain	N/A	Additional Unique Setbacks Apply	No	Zoning Notes/Addendums	Swimming Pool: Must meet requirement R22 of the LDC. Pools shall be located to comply with minimum setbacks for accessory structures- located behind front building line of house, 10' from side & rear property line. Lake lots must meet the 50' setback from the 760 contour line AND the 35' setback from the rear property line. Pools that are not an integral part of the principal building shall be located at least the minimum distance from the principal building necessary to comply with N.C. Building Code. Setback from house could be +/-10'. Fenced with a minimum 4' in height, and equipped with self-closing and positive self-latching gate provided with hardware for permanent locking. Fence not required for above ground pools if they are at least 4' in height, the ladder

removed, or when NOT in use have a gate to the ladder as described above. SETBACK TO STRUCTURE COULD BE MORE OR LESS DEPENDING UPON THE BUILDING CODE; HOWEVER THERE IS A ? FT SET BACK FROM THE PROPERTY LINE.*The setback could change depending on the structure and size of the structure.

Attachment File Name	Added On	Added By	Attachment Group	Notes
Signature_Jill_Booth_10/6/2022.jpg	10/06/2022 14:18	Booth, Jill		Uploaded via CSS
apple valley owner auth_v1.pdf	10/06/2022 14:43	Hart, Ronda	Available Online	Authorize to Act as Agent
apple valley site plan_v1.pdf	10/06/2022 14:43	Hart, Ronda	Available Online	Site Plan

Inspection Number	Status	Inspection Type	Request Date	Scheduled Start Date	Scheduled End Date	Actual Start Date	Actual End Date
2022-34781	Passed - Permit	OSWP Septic/Well Preliminary Site Visit	11/09/2022			11/09/2022 8:18	11/09/2022 8:18

Inspectors: Kobuck, Teanna (Primary)

Checklist Item	Description	Passed	Comments
General Comments	Checklist item used to track general comments, not specific to any other checklist item	No	

Invoice No.	Fee	Fee Amount	Amount Paid
INV-00003250	New Gravity System	$500.00	$500.00
	Total for Invoice INV-00003250	$500.00	$500.00
	Grand Total for Permit	**$500.00**	**$500.00**

Workflow Step / Action Name	Action Type	Start Date	End Date
Application Completeness Check v.1		10/06/2022 0:00	10/06/2022 14:44
Confirm application complete v.1	Generic Action		10/06/2022 14:44
~~**Zoning Review v.1**~~			10/06/2022 14:44
~~Iredell County Zoning Approval v.1~~	Task		10/06/2022 14:44
~~Issue Invoice v.1~~	Generic Action		10/06/2022 14:44
~~Fees Paid v.1~~	Generic Action		10/06/2022 14:44
Fees v.1		10/06/2022 0:00	10/11/2022 15:59
Issue Invoice v.1	Generic Action		10/06/2022 14:44
Fees Paid v.1	Generic Action		10/11/2022 15:59
Lot Readiness Verification v.1		11/10/2022 0:00	
OSWP Septic Preliminary Site Visit v.1	Inspection	11/10/2022 0:00	11/10/2022 8:19
	Inspection		
	Generic Action		
	Generic Action		
	Generic Action		
	Create Sub Permit		
	Generic Action		