IREDELL COUNTY HEALTH DEPARTMENT

STATESVILLE 704-878-5305 100.00 MOORESVILLE 704-664-5281

IMPROVEMENT PERMIT / AUTHORIZATION TO CONSTRUCT / OPERATION PERMIT / EXISTING SYSTEM INSPECTION

PERMIT# 073754 PIN# 4743 05847 DATE Sept. 1, 198

OWNER OR CONTRACTOR For Ken Acres Inc. PHONE: Business 567-9836 Home

ADDRESS 5201 Monroe St. Charlotte 28205

LOCATION Moose Club Rd. TL Snyder Rd. TR Arlie Loop - stay left to Apple Valley Lane - on left

SUBDIVISION Apple Valley BLOCK / SECTION LOT 28 LOT AREA 2.74 ac SITE CLASS. PS DESIGN FLOW 360gpd L.T.A.R. .3

Septic Tank: 1000 Gallons; STB 1012 Date 1-24-00
Pump Tank: Gallons; PT Date
Pump Make: Model Serial No.
Nitrification Field: No Fields 1 Square Feet 1200 Linear Feet 400
No Lines 4 Trench Width 36" Max Trench Bottom Depth 36"

☑ New System ☐ Repair System Type: I. II. III. IV. V. VI
System Description: gravity conventional
Repair System Description: same
Maintenance Agreement Required: ☐ Yes ☑ No
Gravel Depth 12"

☐ House/Mod. Home No. Bedrooms 3
☑ Mobile Home No. Bathrooms 2
☐ Business No. Employees
☐ Other
☐ Slab ☑ Crawl Space ☐ Basement w/plumbing ☐ Basement wo/plumbing


Water Supply: ☑ Individual ☐ Public ☐ Community

Comments:/Conditions:


Comments:/Conditions:

1" = 100'

INITIAL SITE SKETCH

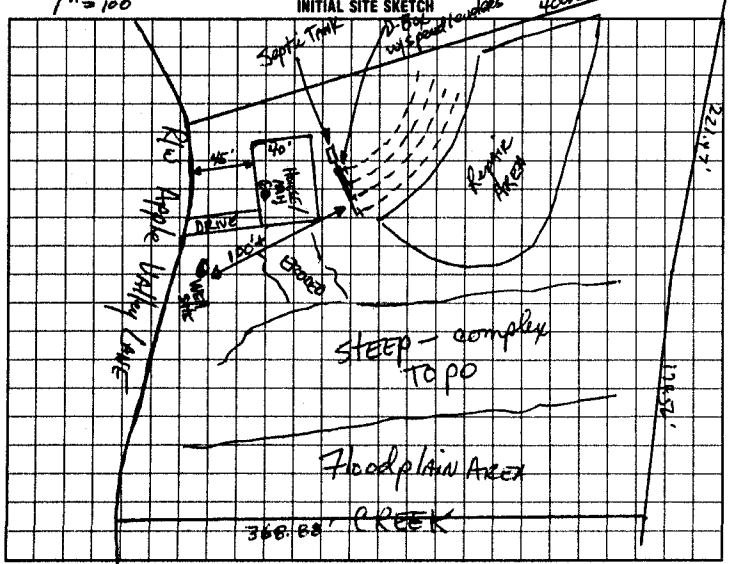

AS BUILT SKETCH

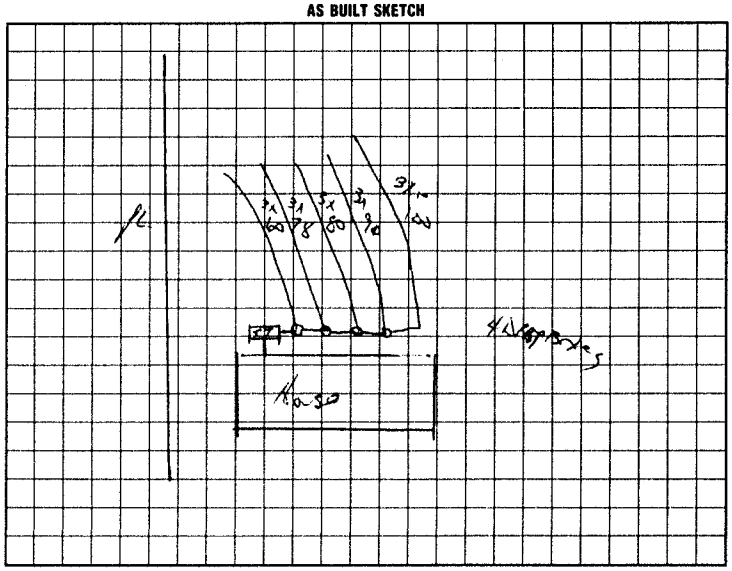

I understand that this permit can be suspended or revoked if any false information is supplied toward securing the permit/any unauthorized changes are made to the site/any unauthorized changes are made in the installation of the system. Improvement Permit with plat valid without expiration. Improvement Permit with site plan valid for sixty months. Authorization to Construct is valid for a period equal to that of Improvement Permit – not to exceed sixty months.

Signed: + Jeff Casey Agent date 4-5-00 Installed by: M Blackmore

Improvement Permit by: David Hamm, RS date 9-1-98 Operation Permit by: J. Potter date May 23 2000

Authorization to Construct by: J. Potter date 9/11/98-2000 Existing System Inspection by: date

HEALTH DEPT. COPY: WHITE INSPECTION COPY (FINAL): GREEN OWNER COPY (FINAL): YELLOW INSPECTION COPY (INITIAL): PINK OWNER COPY (INITIAL): GOLD