IREDELL COUNTY HEALTH DEPARTMENT

STATESVILLE 704-878-5305 125.00 (1) MOORESVILLE 704-664-5281

IMPROVEMENT PERMIT / AUTHORIZATION TO CONSTRUCT / OPERATION PERMIT / EXISTING SYSTEM INSPECTION

PERMIT# 86805 PIN# 4743 ~~10584 PT~~ 12 2044 DATE 4/4/00

OWNER OR CONTRACTOR FOX DEN ACRES PHONE: Business 367-9847 PT Home 704-682-3848

ADDRESS 5201 MONROE RD CHARLOTTE NC 28205

LOCATION 21S - TL MOOSE CLUB - TL SKYUKA - TR ARLIE LOOP - TO APPLE VALLEY - ON LT

SUBDIVISION APPLE VALLEY BLOCK / SECTION ____ LOT 34 LOT AREA 9.56AC SITE CLASS. PS DESIGN FLOW 360 L.T.A.R. .3 gpd/ft²

Septic Tank: 1000 Gallons; STB 1012 Date 4-27-04
Pump Tank: 1000 Gallons; PT 17 Date 5-5-02
Pump Make: GOULDS Model WE 1512H Serial No. ____
Nitrification Field: No Fields 1 Square Feet 1200 Linear Feet 400
No Lines 4@100' Trench Width 36" Max Trench Bottom Depth 36" Gravel Depth 12"

☑ New System ☐ Repair System Type: I, II, (III), IV, V, VI
System Description: ~~PUMP FOR VENTILATOR~~
Repair System Description: SAME 25% REDUCTION PUMP
Maintenance Agreement Required: ☐ Yes ☑ No


☐ House/Mod. Home No. Bedrooms 3
☐ Mobile Home No. Bathrooms 2
☐ Business No. Employees ____
☐ Other ____
☐ Slab ☑ Crawl Space ☐ Basement w/plumbing ☐ Basement wo/plumbing

Water Supply: ☑ Individual ☐ Public ☐ Community


Comments:/Conditions:

Comments:/Conditions: (1) SEPTIC TANK WITH MARKER INSTALLED USING "TUFTITE" FILTER. (2) SYSTEM INSTALLED USING 25% REDUCTION "INFILTRATOR" CHAMBERS

INITIAL SITE SKETCH 1"=200'

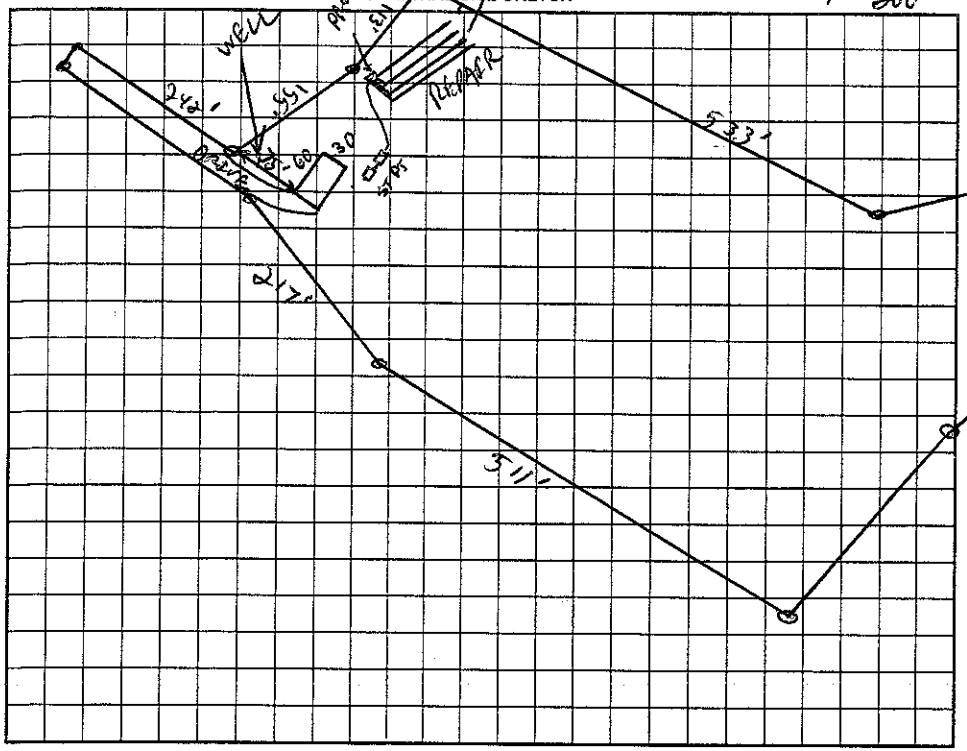

AS BUILT SKETCH

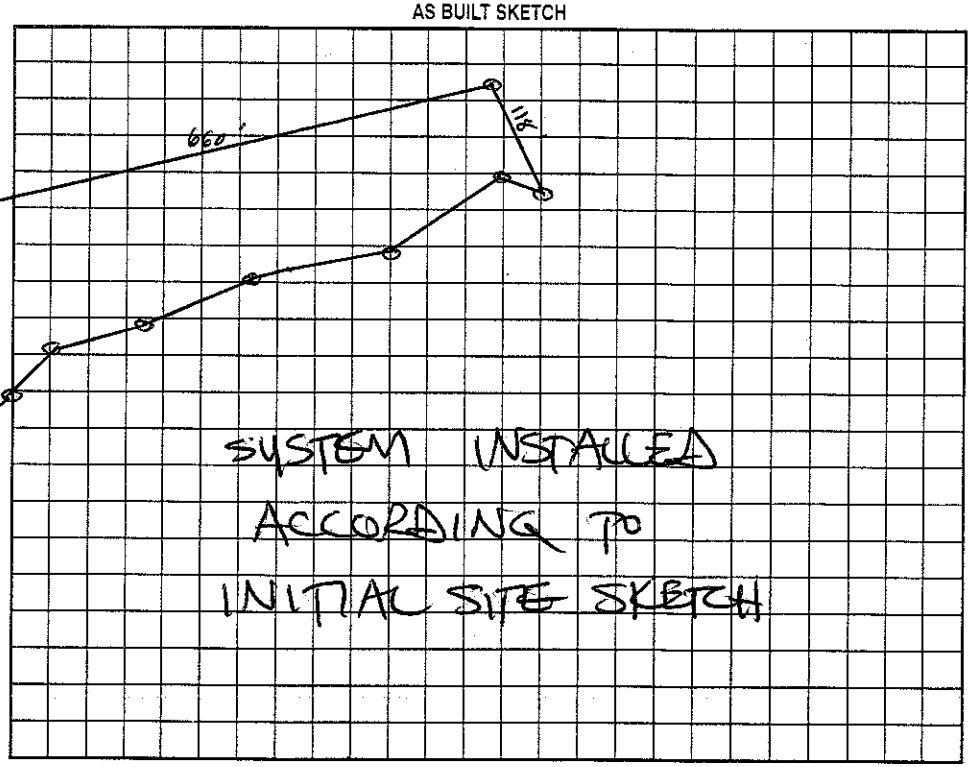

Permit can be suspended or revoked if any false information is supplied toward securing the permit/any unauthorized changes are made to the site/any unauthorized changes are made in the installation of the system. Improvement Permit with plat valid without expiration. Improvement Permit with site plan valid for sixty months. Authorization to Construct is valid for a period equal to that of Improvement Permit – not to exceed sixty months.

Signed: Jeff Casey agent date 4-5-00
Improvement Permit by: C. [illegible] REHS date 4/4/00
Authorization to Construct by: STEVE HEDRICK date 7-27-04

Installed by: A-1 BACK HOE
Operation Permit by: STEVE HEDRICK date 10-26-04
Existing System Inspection by: ____ date ____

HEALTH DEPT. COPY: WHITE OWNER COPY (FINAL): YELLOW OWNER COPY (INITIAL): PINK