ICHD - ENVIRONMENTAL HEALTH DIVISION

Statesville Office (704) 878-5305 | Mooresville Office (704) 660-3625

PERMIT # OSWP-2022-15806

SEPTIC: IMPROVEMENT PERMIT / AUTHORIZATION TO CONSTRUCT / OPERATION PERMIT / EXISTING SYSTEM

PIN # 4743 -- 16 -- 1218

APPLICANT/OWNER: TODD ELLIS

APPLICANT ADDRESS: 271 COOPER FARM ROAD, STATESVILLE, N.C. 28625

SITE ADDRESS: 2005 AMITY HILL ROAD, STATESVILLE, N.C. 28677

PHONE: 704-873-7373

ALT. PHONE 704-902-0119

SITE DIRECTIONS: (3) ON 21, (1) ON AMITY HILL, LOT ON (L)

SAP CONTROLLED: ☐ YES ☐ NO EXT

SUBDIVISION:

SECTION: — LOT # — LOT AREA:

DESIGN FLOW: EXT L.T.A.R.: EXT


Septic Tank	1000 (gal)	STB	1400	Date	12-4-2021	☐ New System	☑ Repair	☐ Expansion	System Type: I II III IV V VI
Pump Tank	— (gal)	PT	—	Date	—	System Description:	EXISTING CONVENTIONAL		
Pump Make	—	Model	—	Serial #	—	Repair System Description:	TANK REPLACEMENT		
# Nitrification Fields	EXT	# Lines	EXT	Linear Ft	EXT	Maintenance Agreement Required:	☐ YES	☑ NO	
Trench Width	EXT	Trench Bottom Depth(Low side)	EXT	Gravel Depth	EXT	☑ GRAVITY	☐ PRESSURE		

☐ Residence	No. Bedrooms	—	**Water Supply**
☑ Business	No. Persons	—	☐ Private
☐ Other	No. Employees	EXT	☑ Public
☑ Slab	☐ Crawl Space		☐ Community
☐ Basement w/plumbing		☐ Basement w/o plumbing	

Comments / Conditions: PUMP, CRUSH AND FILL EXISTING S.T. WITH CONCRETE, DRAINLINE APPEARS TO BE WORK, BUT IS OLD AND UNDER GRAVEL PARKING LOT, NEW TANK MUST BE TRAFFIC RATED


RISERS MUST BE TRAFFIC RATED, NEW SHED MUST BE 5FT FROM TANK & DRAINLINE, DO NOT PAVE OVER DRAINLINE

INITIAL SITE SKETCH

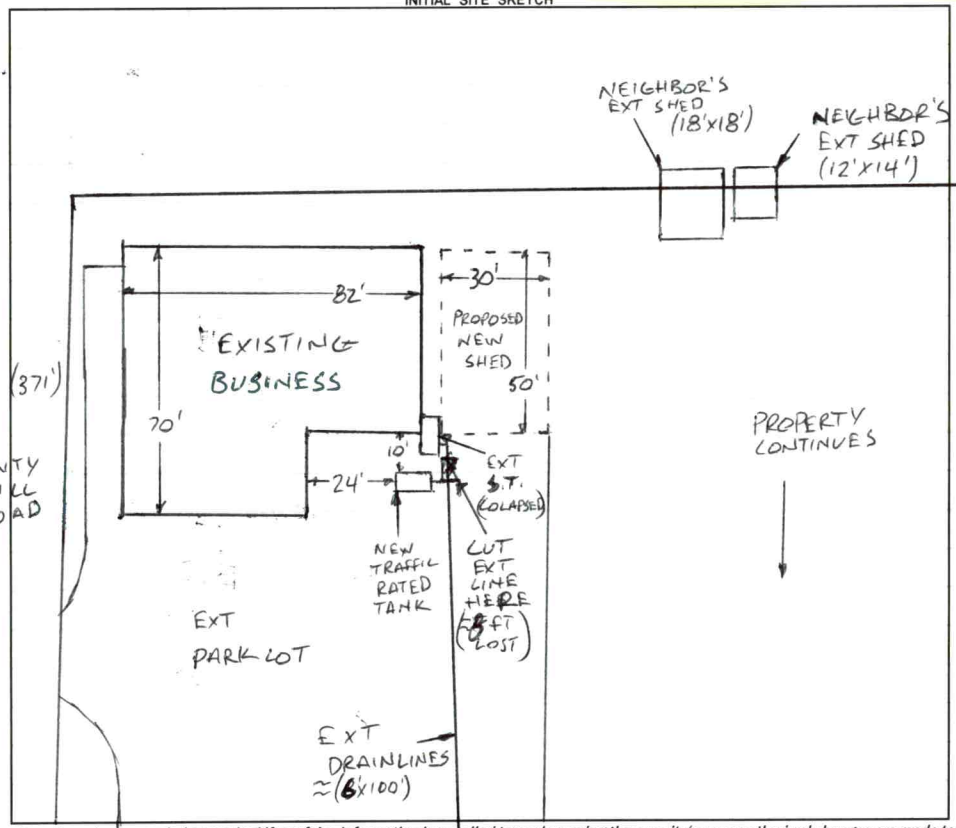

AS BUILT SKETCH

FOR SEPTIC FINAL INSPECTION CALL: 704-664-3703 between 8am-9am
the day the inspection is needed. Be sure to speak with an inspector to confirm your time.

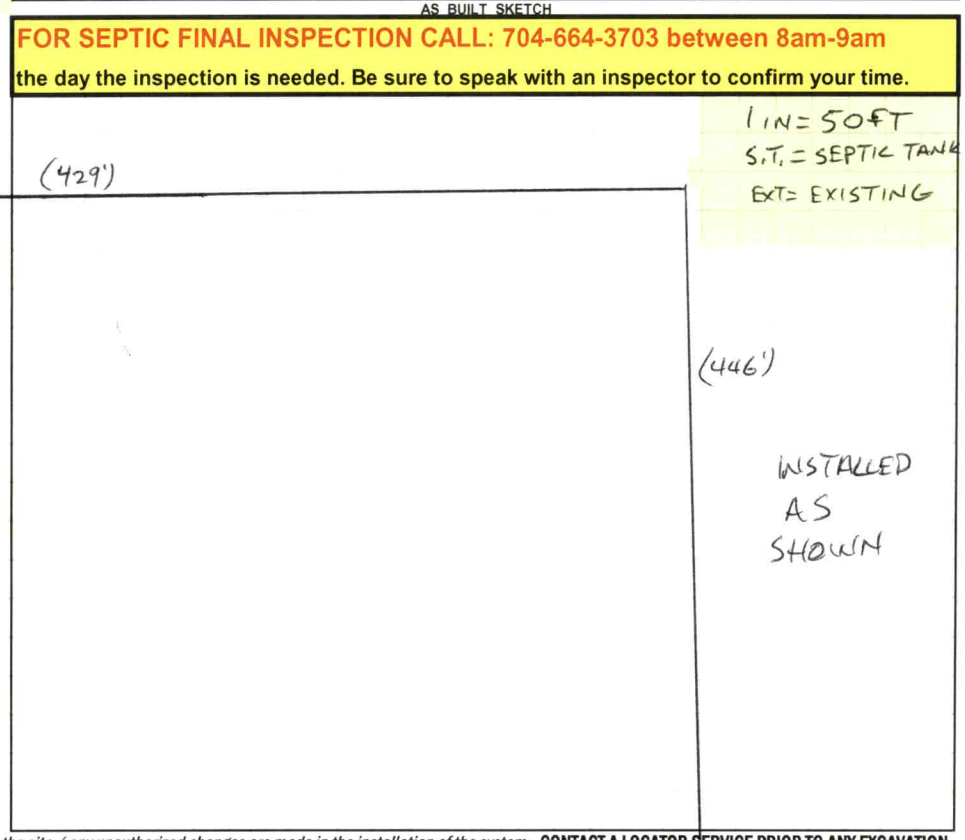

Permit can be suspended or revoked if any false information is supplied toward securing the permit / any unauthorized changes are made to the site / any unauthorized changes are made in the installation of the system. **CONTACT A LOCATOR SERVICE PRIOR TO ANY EXCAVATION**

☐ **IMPROVEMENT PERMIT** ***with plat*** *valid without expiration.* ☑ **IMPROVEMENT PERMIT** ***with site plan*** *valid for 60 mos.* ☑ **AUTHORIZATION TO CONSTRUCT** *valid for period equal to IMPROVEMENT PERMIT--not to exceed 60 mo.*

Owner / Applicant Signature: ONLINE SIGNATURE Date: Installed by: ANDY YOUNTZ

IMPROVEMENT PERMIT by: Bryant C. White Date: 2-10-2022 OPERATION PERMIT by: Bryant C. White Date: 2-10-2023

AUTHORIZATION TO CONSTRUCT by: Bryant C. White Date: 2-10-2022 Existing System Inspected by: Date:

FOR SEPTIC FINAL INSPECTION: CALL 704-664-3703 between 8am-9am the day the inspection is needed.

Item	Date	Initials
Drain Lines Checked		
Tanks Checked		
Pressure Manifold or Valve Box Checked		
Pressure Head Set		
Electrical Checked		
Floats Set		
Alarm Checked		
Maintenance Contract Needed? Y / N		
Comments:		

Repairs Only	
	State Code
Failing System Code	
Type of Distribution	G or P
Type of Failure/Malfunction	
Primary Cause of Failure/Malfunction	
Age of System? _____	
Initial or Repair? _____	

PERMIT SNAPSHOT REPORT OSWP-2023-15806 FOR IREDELL COUNTY

Permit Type: Environmental Health OSWP
Work Class: EH Septic Improvement Permit Repair
Status: PRIORITY PERMIT
Valuation: $0.00
Description: Replace collapsed tank.

Project:
District: Statesville
Square Feet: 0.00
Assigned To: White, Bryant

App Date: 02/07/2023
Exp Date: NOT AVAILABLE
Completed: NOT COMPLETED
Approval Expire Date:

Parcel: 4743161218.000 Main

Address: 2005 Amity Hill Rd Main
Statesville, NC 28677

Zone: HI(Heavy Industrial District)

Applicant/Authorized Agent
Ellis Building Company, LLC
271 Cooper Farm Rd 271
Cooper Farm Road
Statesville, NC 28625
Business: (704) 873-7373

Applicant/Authorized Agent
Todd Ellis
271 Cooper Farm Rd
Statesville, NC 28625
Mobile: (704) 902-0119

Property Owner
Chad Lackey
Home: (704) 872-7286
Business: (704) 872-7286
Mobile: (704) 872-7286

Permit Custom Fields


How is your site plan being submitted	Survey Plat	Does the site contain any jurisdictional wetlands	No	Non-domestic Sewage Generated	No
Other Public Agency	No	Maximum Number of Bedrooms	0	Number of Occupants	0
Foundation Type	Concrete Slab Foundation	Water Supply	City Water	Desired Septic System Type	Conventional (most common)
If other septic system type, please explain		If existing, Year existing system installed	1964	Additional Unique Setbacks Apply	No

Attachment File Name	Added On	Added By	Attachment Group	Notes
Signature_Reita_Gilleland_2/7/2023.jpg	02/07/2023 14:14	Gilleland, Reita		Uploaded via CSS
AuthorizationFormHoovers_v1.pdf	02/08/2023 8:10	Hart, Ronda	Available Online	Authorize to Act as Agent
HooversSepticDrawing_v1.pdf	02/08/2023 8:10	Hart, Ronda	Available Online	Site Plan

Invoice No.	Fee	Fee Amount	Amount Paid
NOT INVOICED	Existing System Septic Repair Permit	$150.00	$0.00
	Total for Invoice NOT INVOICED	$150.00	$0.00
	Grand Total for Permit	**$150.00**	**$0.00**

Workflow Step / Action Name	Action Type	Start Date	End Date
Application Completeness Check v.1		02/08/2023 8:10	02/08/2023 8:10
Confirm application complete v.1	Generic Action		02/08/2023 8:10
Assign v.1			
Case Assigned v.1	Generic Action		
Lot Readiness Verification v.1			
~~OSWP Septic Preliminary Site Visit v.1~~	Inspection		02/08/2023 8:20
OSWP Site Evaluation v.1	Inspection		
~~**Zoning Review v.1**~~			02/08/2023 8:11
~~Issue Invoice v.1~~	Generic Action		02/08/2023 8:11
~~Statesville Zoning Approval v.1~~	Task		02/08/2023 8:11
~~Fees Paid v.1~~	Generic Action		02/08/2023 8:11
Permit Ready v.1			
Issue Permit v.1			
Issue Invoice v.1	Generic Action		
Fees Paid v.1	Generic Action		

Issue Permit v.1	Generic Action
Environment Health Inspections v.1	
Operation Permit Inspection v.1	Inspection

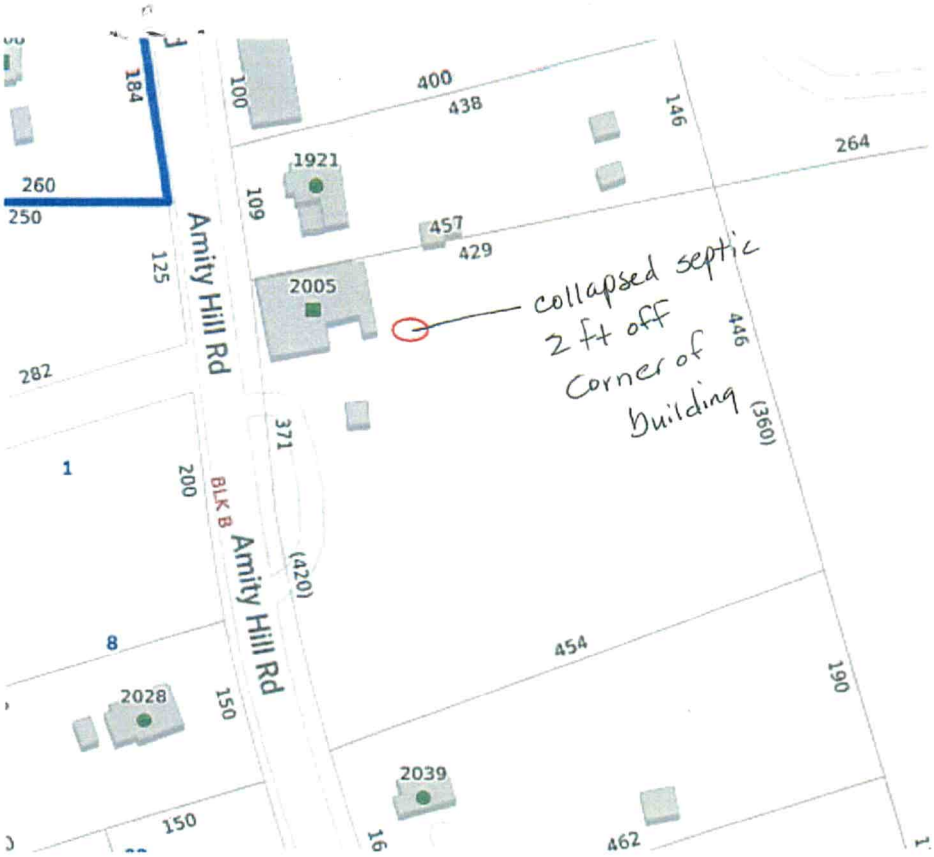
collapsed septic
2 ft off
Corner of
building
Amity Hill Rd
Amity Hill Rd
BLK B
1921
2005
2028
2039
400
438
146
264
457
429
446
(360)
454
190
462
371
(420)
282
260
250
184
125
109
100
200
150
150
1
8