IREDELL COUNTY HEALTH DEPARTMENT

STATESVILLE 704-878-5305 MOORESVILLE 704-664-5281

IMPROVEMENT PERMIT / CERTIFICATE OF COMPLETION / OPERATION PERMIT / EXISTING SYSTEM INSPECTION

PROPERTY DESCRIPTION NO. Repair DATE 7-13-97 TAX MAP NO. Repair Watershed: ☐ Yes ☒ No

OWNER OR CONTRACTOR Susan Godfrey PHONE: Business Home 528-3051

ADDRESS 1618 Wallace Street Statesville NC

LOCATION 215 TL Amity Hill Rd TL Whites Mill Rd TR Walkice St House on (R)

SUBDIVISION BLOCK / SECTION LOT LOT AREA SITE CLASS. #1S DESIGN FLOW 240 L.T.A.R. 0.3

Septic Tank: 1000 Gallons; STB 1012 Date 5-24-97

Pump Tank: Gallons; PT Date

Pump Make: Model Serial No.

Nitrification Field: No Fields 2 Square Feet 702 Linear Feet ~~378~~ 270

No Lines 4 Trench Width 36in Max Trench Bottom Depth 36in Gravel Depth Sand

☑ New System ☒ Repair System Type: I, II, III, IV, V, VI

System Description:

Repair System Description: Grant Chamber

Maintenance Agreement Required: ☐ Yes ☒ No

☒ House/Mod. Home No. Bedrooms 2

☐ Mobile Home No. Bathrooms 1

☐ Business No. Employees

☐ Other


☐ Slab ☒ Crawl Space ☐ Basement w/plumbing ☐ Basement wo/plumbing

Water Supply: ☐ Individual ☐ Community ☒ Public


Comments: Tie All plumbing in to system - old washer box to be filled in keep lines on contour spht feed Lower 3 lines

Comments:

INITIAL SITE SKETCH

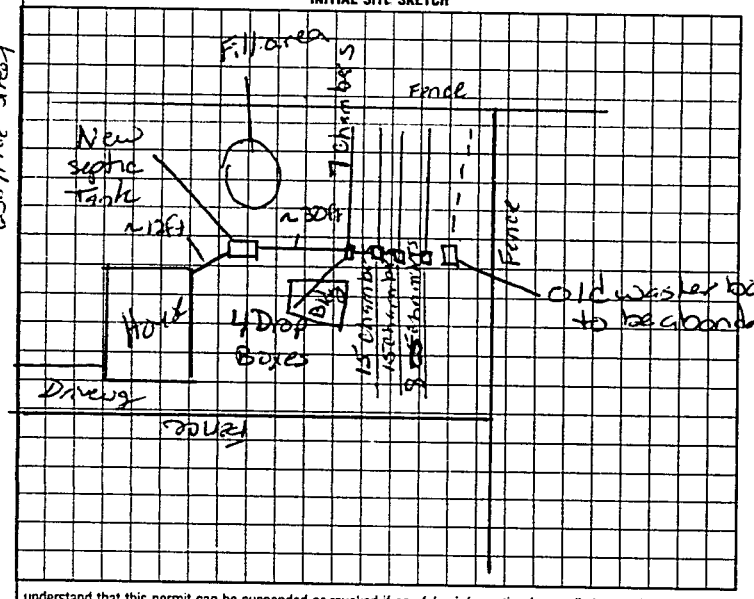

AS BUILT SKETCH

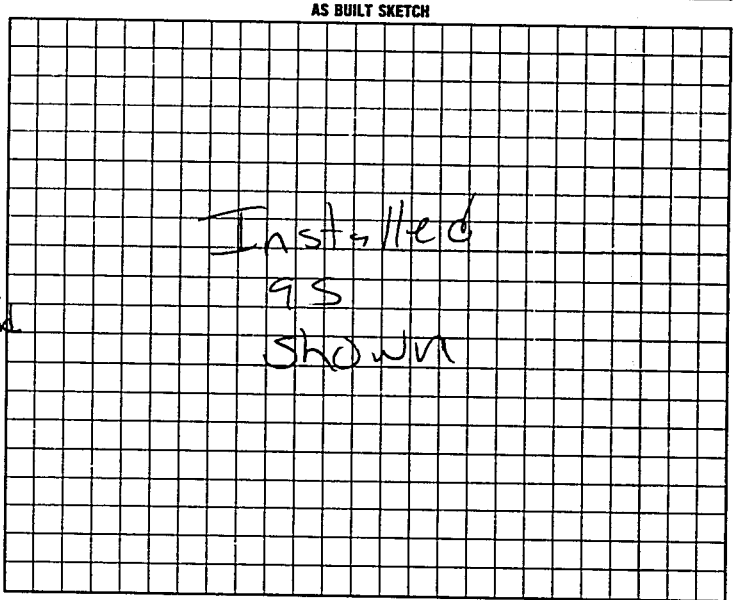

I understand that this permit can be suspended or revoked if any false information is supplied toward securing the permit/any unauthorized changes are made to the site/any unauthorized changes are made in the installation of the system. Improvement Permit is valid for 60 months from date of issuance.

Signed: Susan Godfrey

Improvement Permit by: Mark C Ort RS date 7-13-97

Authorization to Const. Existing System Inspection By: Mark C Ort RS date 7-13-97

Installed by: Steve Jordan

Certificate of Completion by: date

Operation Permit by: Mark C Ort RS date 8-1-97

HEALTH DEPT. COPY: WHITE INSPECTION COPY (FINAL): GREEN OWNER COPY (FINAL): YELLOW INSPECTION COPY (INITIAL): PINK OWNER COPY (INITIAL): GOLD