# IREDELL COUNTY HEALTH DEPARTMENT

Statesville Office (704) 878-5305 Mooresville Office (704) 660-3625 PERMIT # 181536

## IMPROVEMENT PERMIT / AUTHORIZATION TO CONSTRUCT / OPERATION PERMIT / EXISTING SYSTEM

PIN # 4743 17 3996

APPLICANT: Gavin C. Glover APPLICANT ADDRESS: 118 Owl Hollow Ln, Statesville

SITE ADDRESS: 207 Whites Mill Rd, Statesville, NC 28677 PHONE: ALT. PHONE:


SITE DIRECTIONS: Shelton Ave TL Trinity Hill Road immediately TL on Whites Mill Rd 3rd home on left #207

SUBDIVISION: SECTION: LOT # 7 LOT AREA: Existing DESIGN FLOW: L.T.A.R.:

| | | | | | | | | | |
|---|---|---|---|---|---|---|---|---|---|
| Septic Tank 1000 (gal) | STB 160-1000 | Date 8-12-13 | ☐ New System | ☒ Repair | ☐ Expansion | System Type: I II III IV V VI | ☒ Residence | No. Bedrooms 3 | Water Supply |
| Pump Tank (gal) | PT | Date | System Description: | | | | ☐ Business | No. Persons | ☐ Private |
| Pump Make | Model | Serial # | Repair System Description: TANK | | | | ☐ Other | No. Employees | ☒ Public |
| # Nitrification Fields Existing | # Lines | Linear Ft: Existing | Maintenance Agreement Required: | ☐ YES | ☒ NO | | ☐ Slab | ☒ Crawl Space | ☐ Community |
| Trench Width | Max. Trench Bottom Depth | | Gravel Depth | ☒ GRAVITY | ☐ PRESSURE | | ☐ Basement w/plumbing | ☐ Basement w/o plumbing | |

Comments / Conditions: Pumpout, crush & fill old septic tank. Set New Tank 5' minimum from house and deck. Replumb as needed to meet code requirements.

INITIAL SITE SKETCH

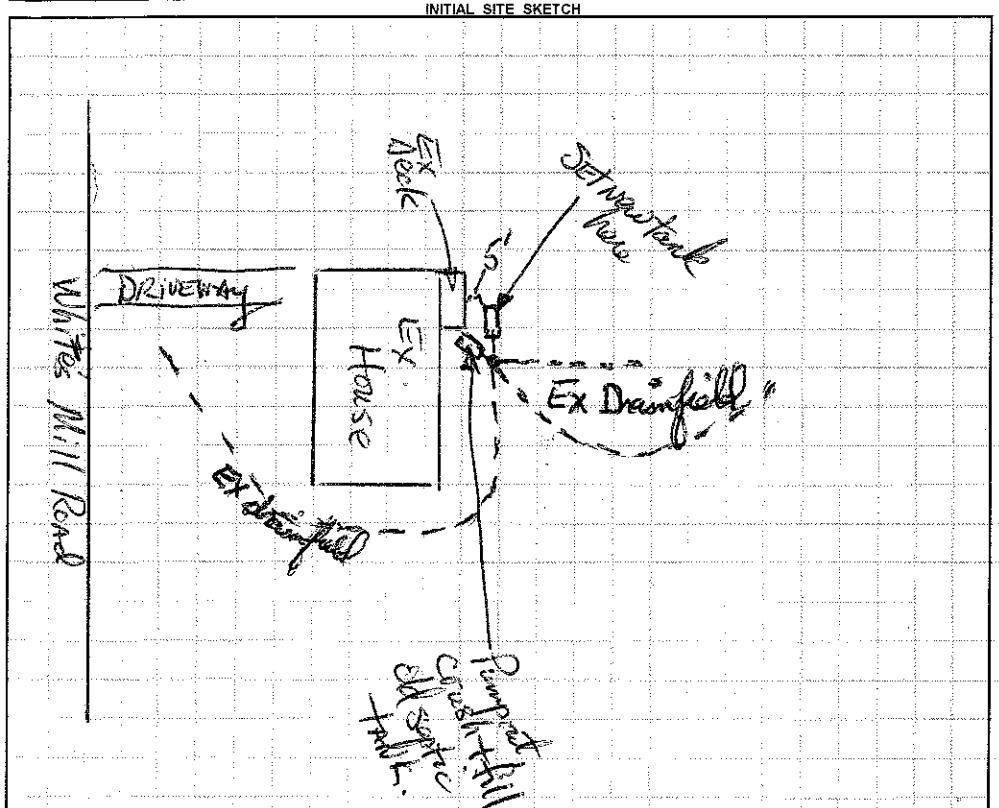


AS BUILT SKETCH

- Red Poly/lok filters installed
- Risers installed over both lids on septic tank

*Permit can be suspended or revoked if any false information is supplied toward securing the permit / any unauthorized changes are made to the site / any unauthorized changes are made in the installation of the system.* **CONTACT A LOCATOR SERVICE PRIOR TO ANY EXCAVATION**

☐ **IMPROVEMENT PERMIT** *with plat valid without expiration.* ☐ **IMPROVEMENT PERMIT** *with site plan valid for 60 mos.* ☒ **AUTHORIZATION TO CONSTRUCT** *valid for period equal to IMPROVEMENT PERMIT--not to exceed 60 mo.*

Owner / Applicant Signature: Jennifer Hupp (realestate agent) Date: 10/22/13 Installed by: K & M Grading

IMPROVEMENT PERMIT by: Date: OPERATION PERMIT by: Justin Henderson Date: 10-24-13

AUTHORIZATION TO CONSTRUCT by: Date: Oct 22, 2013 Existing System Inspected by: Date:

Health Dept. Copy - WHITE Applicant (Final Approval) - YELLOW Applicant (Conditional Approval) - PINK