IREDELL COUNTY HEALTH DEPARTMENT

Statesville Phone TR 3-7271 Mooresville Phone NO 3-1271

PERMIT TO INSTALL SEPTIC TANK

Permit NO. 65 Permit Date 8-15 1972

Owner Carl Nance Jr. Address 223 White Mill Rd

Installed By Carl Nance Jr. Address 217 White Mill Rd


Location of Property 223 White Mill Rd.

Tank		Capacity		Length of Lines		Fixtures	
Block	(✓)	1000	(✓)	225'	(✓)	No. of Baths	(1)
Precast	( )	1250	( )	250'	( )	Dishwasher	( )
		1500	( )	Other		Garbage Grdr.	( )
		Other				Other	

NOTIFY HEALTH DEPARTMENT AT LEAST EIGHT HOURS BEFORE TANK IS TO BE INSPECTED.

Final Inspection 8-15 1972 Approved (✓) Disapproved ( )

Remarks WATER Supply - City of Statesville

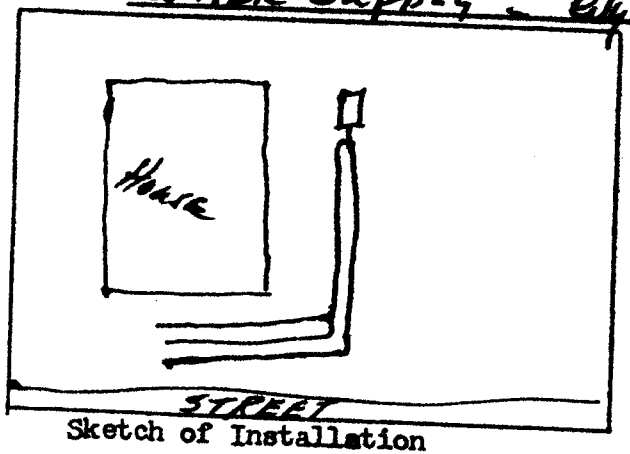

Sketch of Installation

Glenn Fink

Sanitarian