IREDELL COUNTY HEALTH DEPARTMENT

STATESVILLE 704-878-5305 175.00 (24) MOORESVILLE 704-664-5281

IMPROVEMENT PERMIT / AUTHORIZATION TO CONSTRUCT / OPERATION PERMIT / EXISTING SYSTEM INSPECTION

PERMIT# 086826 PIN# 474 Date 4-5-00

OWNER OR CONTRACTOR ~~FOX DEN ACRES~~ Teresa Wilson PHONE: Business ~~567-9880~~ Home

ADDRESS 5201 MONROE RD CHARLOTTE NC 28205

LOCATION 21 S - TL MOOSE CLUB RD - TL SKYUKA RD - TR ARLIE LOOP TO APPLE VALLEY - ON LEFT

SUBDIVISION APPLE VALLEY BLOCK / SECTION LOT 24 LOT AREA .94 Ac SITE CLASS PS DESIGN FLOW 360gal L.T.A.R. .3gal/Ac

Septic Tank: 1000 Gallons; STB 160 Date 4-25-01
Pump Tank: Gallons; PT Date
Pump Make: Model Serial No.
Nitrification Field: No Fields 1 Square Feet 900 Linear Feet 300
No Lines 3@100' Trench Width 36" Max Trench Bottom Depth 24" Gravel Depth N/A

☑ New System ☐ Repair System Type: I. II. III. IV. V. VI
System Description: GRAVITY INNOVATIVE
Repair System Description: SAME
Maintenance Agreement Required: ☐ Yes ☑ No

☑ House/Mod. Home No. Bedrooms 3
☐ Mobile Home No. Bathrooms 2
☐ Business No. Employees
☐ Other


☐ Slab ☑ Crawl Space ☐ Basement w/plumbing ☐ Basement wo/plumbing

Water Supply: ☑ Individual ☐ Public ☐ Community


Comments/Conditions: 1) KEEP WELL 100' FROM ANY SEPTIC SYSTEM. 2) INSTALL AN INSPECTION PORT ON END OF EACH LINE.

Comments/Conditions: SEPTIC TANK WITH MARKED INSTALLED USING "ZABEL" FILTER

INITIAL SITE SKETCH 1"=50'

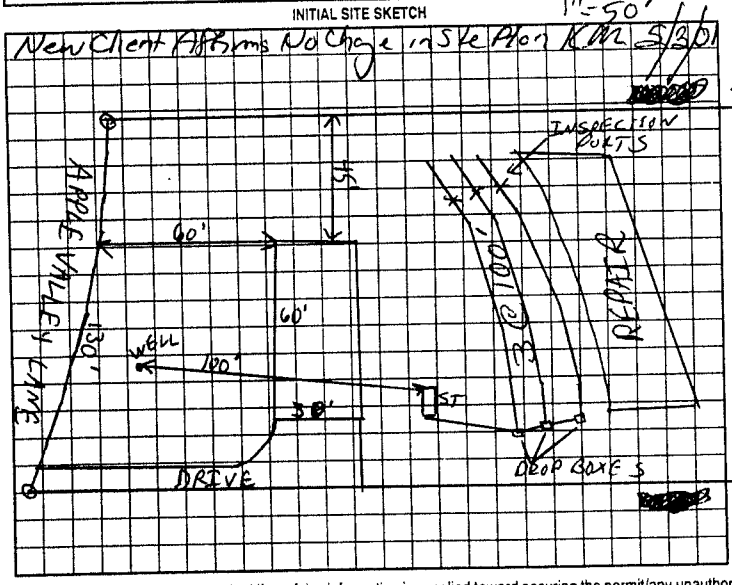

AS BUILT SKETCH

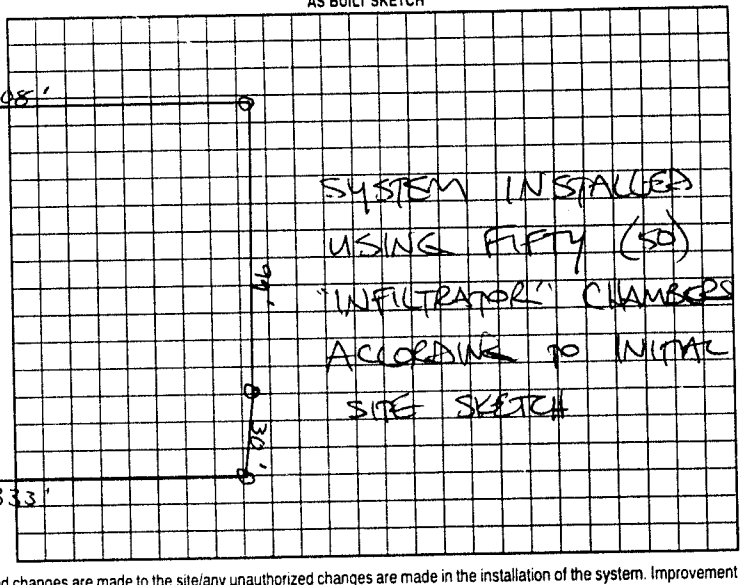

Permit can be suspended or revoked if any false information is supplied toward securing the permit/any unauthorized changes are made to the site/any unauthorized changes are made in the installation of the system. Improvement Permit with plat valid without expiration. Improvement Permit with site plan valid for sixty months. Authorization to Construct is valid for a period equal to that of Improvement Permit – not to exceed sixty months.

Signed: Jeff Casey agent date 4-5-00
Improvement Permit by: C. [illegible] PS date 4/4/00
Authorization to Construct by: [illegible] date 5/3/00

Installed by: LEATHERMAN SEPTIC TANK
Operation Permit by: STEVE HENDRICK date 6-14-01
Existing System Inspection by: date

HEALTH DEPT. COPY WHITE OWNER COPY (FINAL) YELLOW OWNER COPY (INITIAL) PINK