# IREDELL COUNTY HEALTH DEPARTMENT

STATESVILLE 704-878-5305 MOORESVILLE 704-664-5281

## IMPROVEMENT PERMIT / AUTHORIZATION TO CONSTRUCT / OPERATION PERMIT / EXISTING SYSTEM INSPECTION

PERMIT# 25618 - 95245 PIN# 4743 02 7105 DATE 3/12/01

OWNER OR CONTRACTOR FOX DEN INC. PHONE: Business (704) 567-9720 Home

ADDRESS 5201 MONROE RD, CHARLOTTE, NC

LOCATION I-77 S. EXIT 45 (R) AMITY HILL RD. ON (L) ACROSS FROM FOX DEN C.C.

SUBDIVISION FOX DEN AC. BLOCK / SECTION LOT 2 LOT AREA 16 Ac. SITE CLASS PS DESIGN FLOW 480 GPD L.T.A.R. .35

Septic Tank: 1000 Gallons: STB 1012 Date 4-17-01
Pump Tank: 1000 Gallons: PT 17 Date 10-15-00
Pump Make: GOULDS Model WE0512H Serial No 6015839H
Nitrification Field: No Fields 1 Square Feet 1371 Linear Feet 400
No Lines 4 Trench Width 3 Max Trench Bottom Depth 22" Gravel Depth 12"

☑ New System ☐ Repair System Type: I, II, III, IV, V, VI
System Description: CONVENTIONAL PUMP
Repair System Description: SAME
Maintenance Agreement Required: ☐ Yes ☑ No
☐ Slab ☑ Crawl Space ☐ Basement w/plumbing ☐ Basement wo/plumbing


☑ House/Mod. Home No. Bedrooms 4
☐ Mobile Home No. Bathrooms 3
☐ Business No. Employees
☐ Other

Water Supply: ☑ Individual ☐ Public ☐ Community

Comments/Conditions (1) NO CUTTING OR FELLING OVER DRAINFIELD/REPAIR AREAS (2) KEEP ALL DRAINS AWAY FROM DRAINFIELD/REPAIR AREAS (3) MAINTAIN SETBACKS (4) INSTALL DRAINLINES UNIFORM AND ON CONTOUR.

Comments/Conditions (1) SEPTIC TANK WITH MARKER INSTALLED (2) USING "POLYLOK" FILTER (3) SYSTEM PRESSURE CHECKED 8:28-01, RSH.

INITIAL SITE SKETCH NOT TO SCALE

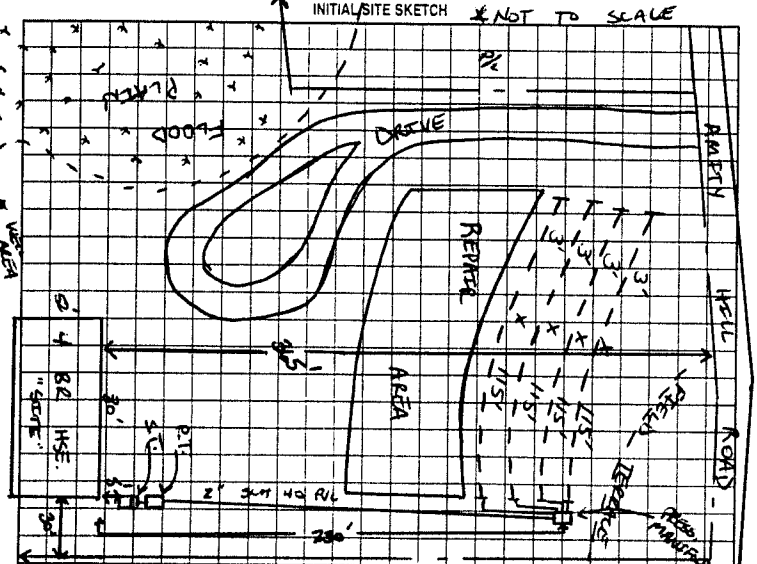


AS BUILT SKETCH

SYSTEM INSTALLED ACCORDING TO INITIAL SITE SKETCH

Permit can be suspended or revoked if any false information is supplied toward securing the permit/any unauthorized changes are made to the site/any unauthorized changes are made in the installation of the system. Improvement Permit with plat valid without expiration. Improvement Permit with site plan valid for sixty months. Authorization to Construct is valid for a period equal to that of Improvement Permit – not to exceed sixty months.

Signed: Richard A Murphy date 3-13-2001 Installed by: TOMMY FRYE

Improvement Permit by: Danny Shinn date 3/12/01 Operation Permit by: STEVE HENDRICK date 11-21-01

Authorization to Construct by: Danny Shinn date 3/12/01 Existing System Inspection by: date

HEALTH DEPT COPY WHITE OWNER COPY (FINAL) YELLOW OWNER COPY (INITIAL) PINK