IREDELL COUNTY HEALTH DEPARTMENT

Statesville Phone TR 3-7271 Mooresville Phone NO 3-1271

PERMIT TO INSTALL SEPTIC TANK

Permit NO. _____ Steadman Rlty Co Permit Date May - 18 -1962

Owner _____ Address Wall St.

Installed By Hoke R7 Address _____


Location of Property on right before end of pave ment -

| Tank | | Capacity | | Length of Lines | | Fixtures | |
|---|---|---|---|---|---|---|---|
| Block | ( ) | 800 | ( ) | 150' | ( ) | No. of Baths | (1 1/2) |
| Precast | (✓) | 900 | ( ) | 175' | ( ) | Dishwasher | ( ) |
| | | 1000 | (✓) | 200' | ( ) | Garbage Grdr. | ( ) |
| | | 1100 | ( ) | 225' | (✓) | Auto-Washer | ( ) |
| | | 1200 | ( ) | 250' | ( ) | Other _____ | |
| | | Other _____ | | Other _____ | | | |

NOTIFY HEALTH DEPARTMENT AT LEAST EIGHT HOURS BEFORE TANK IS TO BE INSPECTED.

Final Inspection 5-18-1962 Approved (✓) Disapproved ( )

Remarks lots 23-24 - V.A.# 91764 - Narrow lot - City Water

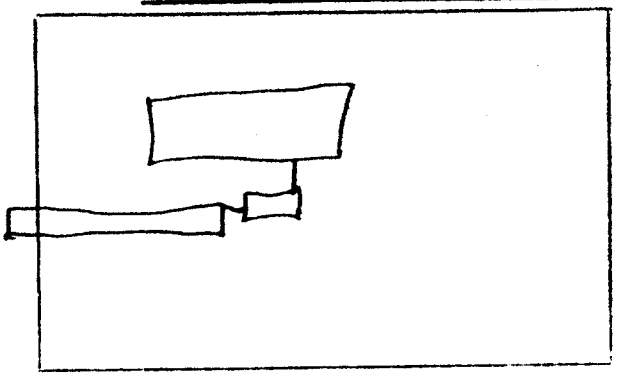

Sketch of Installation

Pat

Sanitarian