IREDELL COUNTY HEALTH DEPARTMENT

STATESVILLE 704-878-5305 175.00 Paid MOORESVILLE 704-664-5281

IMPROVEMENT PERMIT / AUTHORIZATION TO CONSTRUCT / OPERATION PERMIT / EXISTING SYSTEM INSPECTION

PERMIT# 09989/90953 PIN# 4743-68-0975 DATE July 11, 2000

OWNER OR CONTRACTOR Ollie R. Kimbrough Jr. PHONE: Business 872-8964 Home

ADDRESS 1122 Wall St. Statesville

LOCATION From I-77 - Weston Hwy 70 TL 1st Street (Wall Street - @ "Microtel") on Right before end of pavement

SUBDIVISION BLOCK / SECTION LOT LOT AREA 1 ac ± SITE CLASS IS DESIGN FLOW 360 gpd L.T.A.R. .3

Septic Tank: 1000 Gallons; STB Date

Pump Tank: Gallons; PT Date

Pump Make: Model Serial No.

Nitrification Field: No Fields 1 Square Feet 900 Linear Feet 300

No Lines 5@60' Trench Width 36" Max Trench Bottom Depth 36"

☒ New System ☐ Repair System Type: I, II, ☒ III, IV, V, VI

System Description: Gravity Innovative-25% Reduction

Repair System Description: Sand Pumped Innovative-25% Red

Maintenance Agreement Required: ☐ Yes ☒ No

Gravel Depth NA ☐ Slab ☑ Crawl Space ☐ Basement w/plumbing ☐ Basement wo/plumbing

☒ House/Mod. Home No. Bedrooms 3

☐ Mobile Home No. Bathrooms 2

☐ Business No. Employees

☐ Other


Water Supply: ☐ Individual ☒ Public ☐ Community

Comments:/Conditions:


@ ONE INSPECTION PORT PER LATERAL, SET FLUSH WITH FINISH GRADE.

Comments:/Conditions:

INITIAL SITE SKETCH

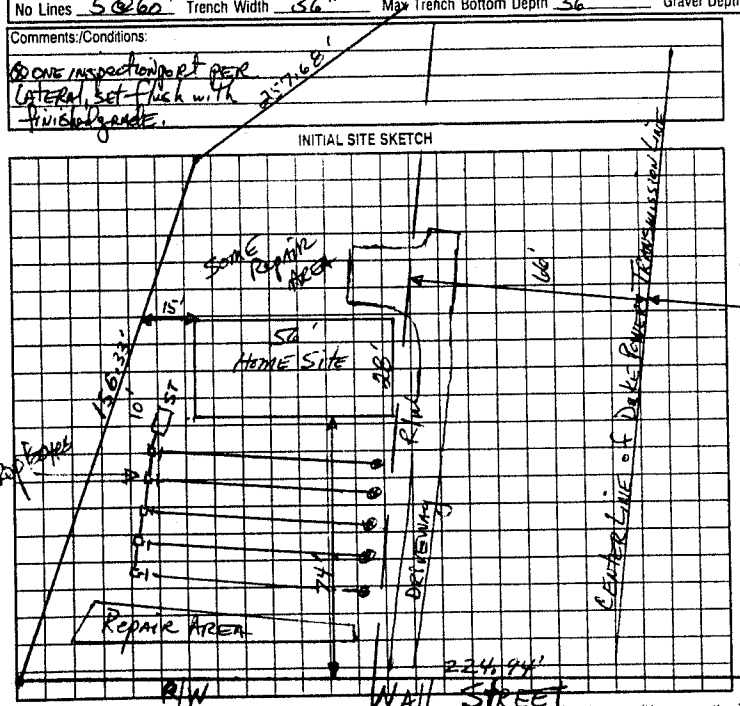

AS BUILT SKETCH

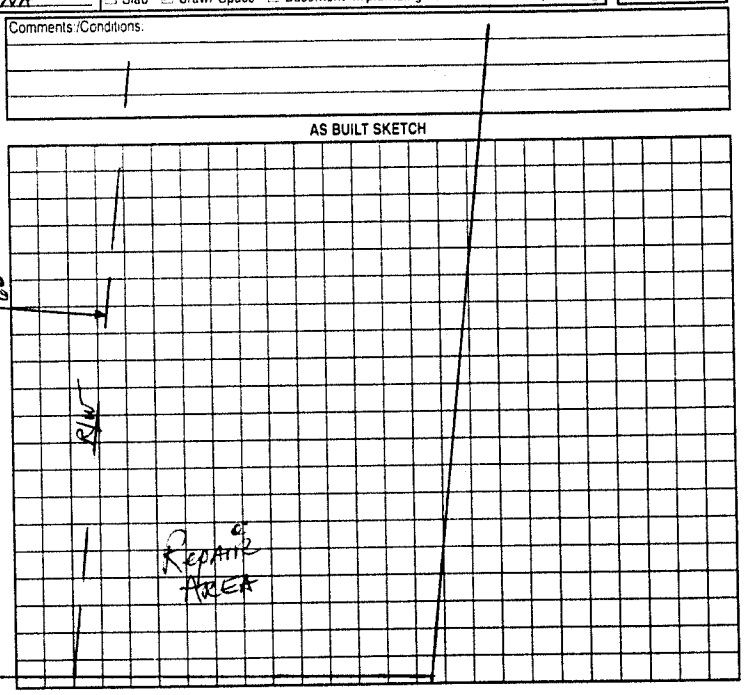

Permit can be suspended or revoked if any false information is supplied toward securing the permit/any unauthorized changes are made to the site/any unauthorized changes are made in the installation of the system. Improvement Permit with plan valid without expiration. Improvement Permit with site plan valid for sixty months. Authorization to Construct is valid for a period equal to that of Improvement Permit – not to exceed sixty months.

Signed: date 7-11-00 Installed by: Craig Thompson

Improvement Permit by: date 7-11-00 Operation Permit by: date 7/11/2000

Authorization to Construct by: date 7-11-00 Existing System Inspection by: date

HEALTH DEPT. COPY. WHITE OWNER COPY (FINAL). YELLOW OWNER COPY (INITIAL). PINK