IREDELL COUNTY HEALTH DEPARTMENT

THIS PERMIT SERVES AS "NOTICE OF VIOLATION"

STATESVILLE 704-878-5305 MOORESVILLE 704-664-5281

IMPROVEMENT PERMIT / AUTHORIZATION TO CONSTRUCT / OPERATION PERMIT / EXISTING SYSTEM INSPECTION

PERMIT# REPAIR PIN# 4743.68.3257 DATE 7-29-00

OWNER OR CONTRACTOR KATIE HARRINGTON PHONE: Business Home 924-7674

ADDRESS 115 W. RALEIGH AV. STATESVILLE, NC 28677

LOCATION GARNER BAGNEL BLVD, TO WALL STREET, HOUSE ON RIGHT AT # 1304

SUBDIVISION J.C. GANT BLOCK / SECTION LOT 5 LOT AREA LIMITED SITE CLASS. PS DESIGN FLOW 240 L.T.A.R. EXISTING

NEW

Septic Tank: 1000 Gallons; STB 1000 Date 9-11-03

Pump Tank: Gallons; PT Date

Pump Make: Model Serial No.

Nitrification Field: No Fields 1 Square Feet 390 Linear Feet 130

No Lines THREE Trench Width 36" Max Trench Bottom Depth 36" Gravel Depth 26"

☐ New System ☑ Repair System Type: I II III IV V VI

System Description: CONVENTIONAL GRAVITY

Repair System Description: CONVENTIONAL GRAVITY

Maintenance Agreement Required: ☐ Yes ☑ No

☑ House/Mod. Home ☐ Mobile Home ☐ Business ☐ Other

No. Bedrooms 2 No. Bathrooms 1 No. Employees

☐ Slab ☑ Crawl Space ☐ Basement w/plumbing ☐ Basement wo/plumbing


Water Supply: ☑ Individual ☐ Public ☐ Community

WELL

Comments:/Conditions: ① SYSTEM TO BE REPAIRED PRIOR TO OCCUPANCY ② INSTALL NEW SEPTIC TANK AS SHALLOW AS POSSIBLE AND TIE ALL PLUMBING INTO NEW TANK ③ INSTALL NEW LINES AS FLAGGED, WHICH MAY INTERSECT OLD "CINDER" LINES USING 26" STONE DEPTH.

Comments:/Conditions: SEPTIC TANK WITH MARKER INSTALLED USING "TUFTITE" FILTER

INITIAL SITE SKETCH

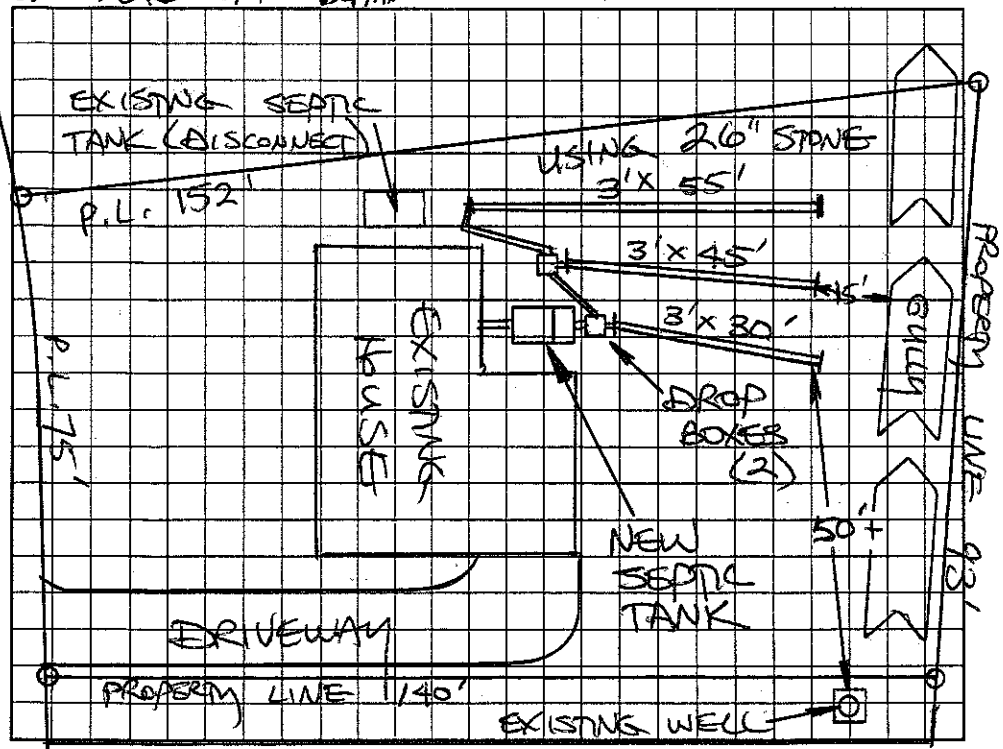

AS BUILT SKETCH

SYSTEM REPAIRED ACCORDING TO INITIAL SITE SKETCH

Permit can be suspended or revoked if any false information is supplied toward securing the permit/any unauthorized changes are made to the site/any unauthorized changes are made in the installation of the system. Improvement Permit with plat valid without expiration. Improvement Permit with site plan valid for sixty months. Authorization to Construct is valid for a period equal to that of Improvement Permit – not to exceed sixty months.

Signed: Katie Harrington date 8-14-03 Installed by: BARNES BACKHOE & GRADING

Improvement Permit by: STEVE HENDRICK date 7-29-00 Operation Permit by: STEVE HENDRICK date 11-10-03

Authorization to Construct by: STEVE HENDRICK date 7-29-00 Existing System Inspection by: date

HEALTH DEPT. COPY: WHITE OWNER COPY (FINAL): YELLOW OWNER COPY (INITIAL): PINK