133' - 240'

IREDELL COUNTY HEALTH DEPARTMENT

STATESVILLE 704-878-5305 MOORESVILLE 704-664-5281

IMPROVEMENT PERMIT / AUTHORIZATION TO CONSTRUCT / OPERATION PERMIT / EXISTING SYSTEM INSPECTION

PERMIT# REPAIR PIN# 4743-69-0498 DATE 1-20-05

OWNER OR CONTRACTOR WILLIAM CLAYTON ABSHER PHONE: Business Home (561) 703-7557

ADDRESS 3108 NEALWOOD AVE #388 ORLANDO, FL 32806

LOCATION GARNER BAGNAL BLVD TO WALL STREET, HOUSE ON LEFT AT HOPE STREET Box #1101

SUBDIVISION M. MILLER BLOCK / SECTION LOT 1 LOT AREA 0.17 ACRE SITE CLASS. PS DESIGN FLOW 360 L.T.A.R. 0.30 GPD/FT²

Septic Tank: EXISTING Gallons; STB Date

NEW Pump Tank: 1000 Gallons; PT 17 Date 5-28-04

Pump Make: GOULDS Model EP04112A Serial No. J0449967

Nitrification Field: No Fields 1 Square Feet EQ. TO 720 Linear Feet 120

No Lines FOUR Trench Width 24" Max Trench Bottom Depth 36" ~~Gravel~~ Depth SAND 24"

☐ New System ☑ Repair System Type: I, II, (III), IV, V, VI

System Description: CONVENTIONAL, GRAVITY

Repair System Description: 50% REDUCTION, PUMP

Maintenance Agreement Required: ☐ Yes ☑ No

☑ House/Mod. Home No. Bedrooms 3

☐ Mobile Home No. Bathrooms

☐ Business No. Employees

☐ Other


☐ Slab ☑ Crawl Space ☐ Basement w/plumbing ☐ Basement wo/plumbing

Water Supply: ☐ Individual ☑ Public ☐ Community

Comments:/Conditions: ① INSTALL NEW PUMP TANK (1000 GAL) AT LOCATION SHOWN ② INSTALL 50% REDUCTION SYSTEM ON CONTOUR AS FLAGGED USING 28 PPRPS PANELS ③ SEE ATTACHED SHEETS FOR PUMP & PRESSURE MANIFOLD REQUIREMENTS

Comments:/Conditions: ④ KEEP SYSTEM MINIMUM 5 FEET FROM PROPERTY LINE (15A NCAC 18A .1951 (a)(c)(3)). ⑤ NO VEHICULAR TRAFFIC ALLOWED OVER SYSTEM.

INITIAL SITE SKETCH

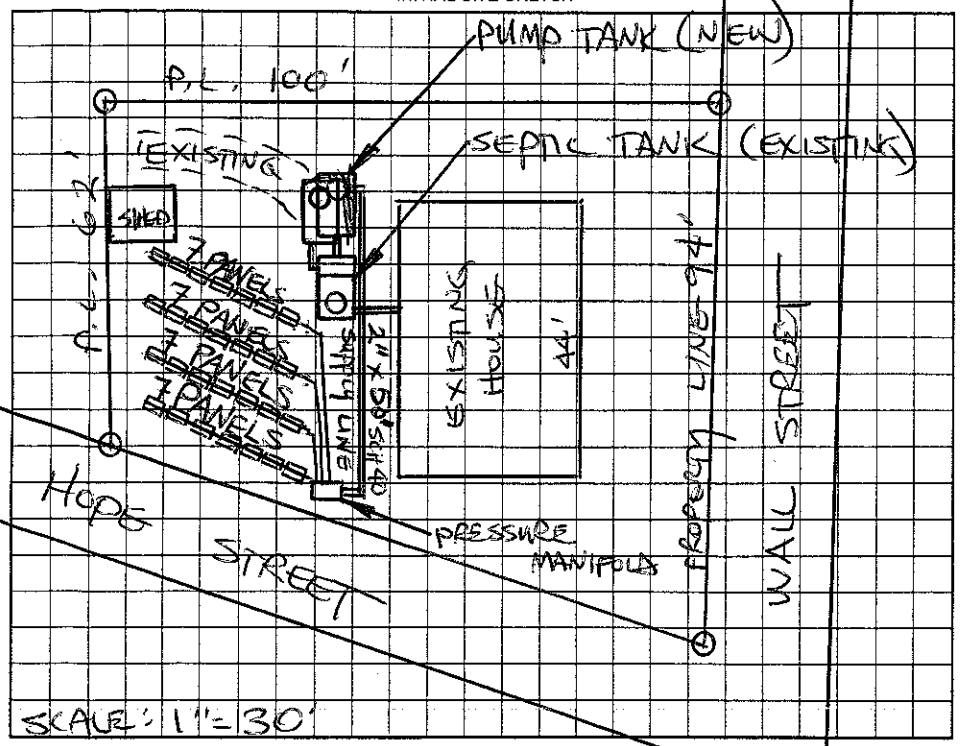

AS BUILT SKETCH

SYSTEM REPAIRED ACCORDING TO INITIAL SITE SKETCH

Permit can be suspended or revoked if any false information is supplied toward securing the permit/any unauthorized changes are made to the site/any unauthorized changes are made in the installation of the system. Improvement Permit with plat valid without expiration. Improvement Permit with site plan valid for sixty months. Authorization to Construct is valid for a period equal to that of Improvement Permit – not to exceed sixty months.

Signed: [signature] date 3/1/05 Installed by: C & S GRADING

Improvement Permit by: STEVE HEDRICK date 1-20-05 Operation Permit by: STEVE HEDRICK date 4.27.05

Authorization to Construct by: STEVE HEDRICK date 1-20-05 Existing System Inspection by: date

HEALTH DEPT. COPY: WHITE OWNER COPY (FINAL): YELLOW OWNER COPY (INITIAL): PINK