IREDELL COUNTY HEALTH DEPARTMENT

Statesville Phone TR 3-7271 Mooresville Phone No. 664-5281

PERMIT TO INSTALL SEPTIC TANK

Permit No. 411 Permit Date 1 June 1973

Owner Mrs. SARA Buetow Address 1013 Wall St.

Installed By Henry Sigmon Address Statesville, NC.


Location of Property off Mocksville St - Wall St. - 1013 on Left

Tank	Capacity	Length of Lines	Fixtures
~~Block~~ ( )	1000 ( )	225' ( )	No. of Baths (1)
~~Precast~~ ( )	1250 ( )	250' ( )	Dishwasher ( )
REPAIR	1500 ( )	Other 156'	Garbage Grdr. ( )
	Other		Other

NOTIFY HEALTH DEPARTMENT AT LEAST EIGHT HOURS BEFORE TANK IS TO BE INSPECTED.

Final Inspection 1 June 1973 Approved (✓) Disapproved ( )

Remarks

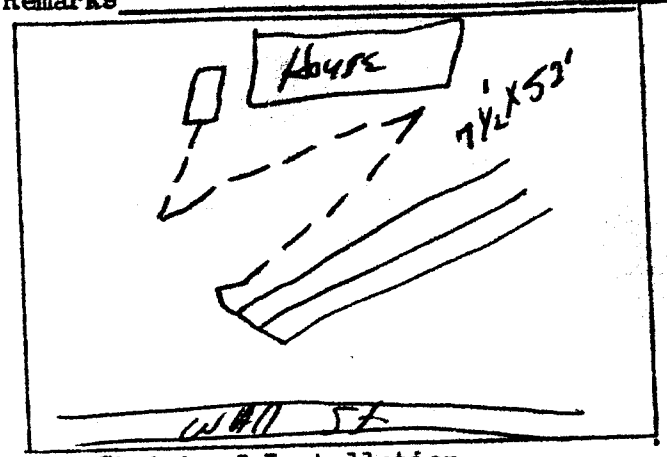

Sketch of Installation

William M. Howard

Sanitarian