Not on B/C 1

IREDELL COUNTY HEALTH DEPARTMENT

Statesville Phone TR 3-7271 Mooresville Phone NO 3-1271

PERMIT TO INSTALL SEPTIC TANK

Permit No. _____ Permit Date 5-1 1972

Owner B+S Builders Address Statesville, NC

Installed By Roy Lentz Address Statesville, NC

Location of Property Hull St.

Lots No. at 129-132


(1st House on Left)

Tank		Capacity		Length of Lines		Fixtures	
Block	( )	1000	(✓)	225'	( )	No. of Baths	(1)
Precast	(✓)	1250	( )	250'	( )	Dishwasher	( )
		1500	( )	Other 300		Garbage Grdr.	( )
		Other _____		900 Sq. Ft.		Other _____	

NOTIFY HEALTH DEPARTMENT AT LEAST EIGHT HOURS BEFORE TANK IS TO BE INSPECTED.

Final Inspection 5-1 1972 Approved (✓) Disapproved ( )

Remarks City Water

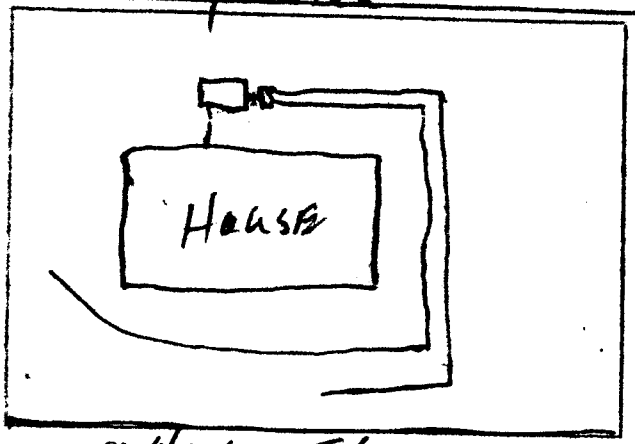

Sketch of Installation

Glenn Fox Jr.
Sanitarian