IREDELL COUNTY HEALTH DEPARTMENT

Statesville Phone TR 3-7271 Mooresville Phone NO 3-1271

PERMIT TO INSTALL SEPTIC TANK

Permit No. 112 Permit Date 6-7 1972

Owner B & S Builders Address Statesville, NC.

Installed By Ray Lentz Address Statesville, NC

Location of Property Hull St

Lot # 91-94


LAST House on Rt

| Tank | | Capacity | | Length of Lines | | Fixtures | |
|---|---|---|---|---|---|---|---|
| Block | ( ) | 1000 | (✓) | 225' | ( ) | No. of Baths | (1) |
| Precast | (✓) | 1250 | ( ) | 250' | ( ) | Dishwasher | ( ) |
| | | 1500 | ( ) | Other 300 | | Garbage Grdr. | ( ) |
| | | Other | | 900 Sq ft. | | Other | |

NOTIFY HEALTH DEPARTMENT AT LEAST EIGHT HOURS BEFORE TANK IS TO BE INSPECTED.

Final Inspection 6-7 1972 Approved (✓) Disapproved ( )

Remarks

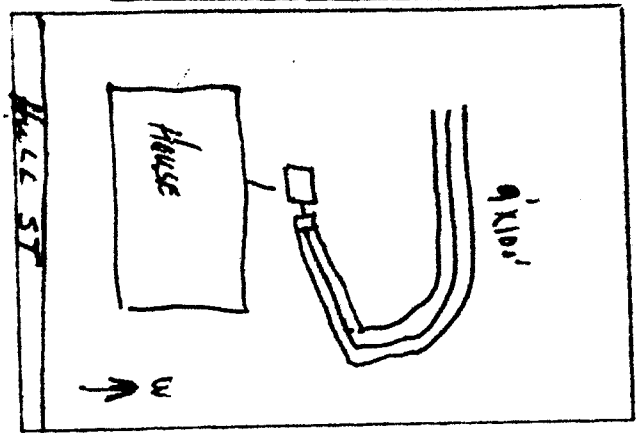


Sketch of Installation

Glenn Tolson

Sanitarian