IREDELL COUNTY HEALTH DEPARTMENT

Statesville Phone TR 3-7271 Mooresville Phone NO 3-1271

PERMIT TO INSTALL SEPTIC TANK

Permit NO. S Teadman Permit Date 5-16-1962

Owner Bill Thompson Address Circle Dr. Glen Echo.

Installed By C Hoke Address R 1


Location of Property Lot #10 - Glen Echo. on Circle

Tank	Capacity	Length of Lines	Fixtures
Block ( )	800 ( )	150' ( )	No. of Baths (1½)
Precast (✓)	900 ( )	175' ( )	Dishwasher ( )
	1000 (✓)	200' ( )	Garbage Grdr. ( )
rash	1100 ( )	225' (✓)	Auto-Washer (✓)
	1200 ( )	250' ( )	Other
	Other	Other	

NOTIFY HEALTH DEPARTMENT AT LEAST EIGHT HOURS BEFORE TANK IS TO BE INSPECTED.

Final Inspection 5-16 1962 Approved (✓) Disapproved ( )

Remarks V.A. # 90964 - city water Very heavily wooded. ditch 7' wide narrow lot

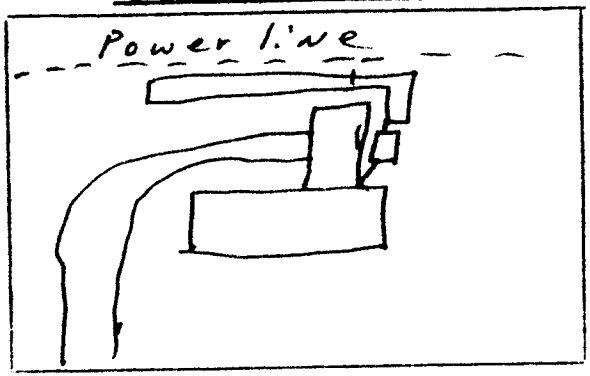

Sketch of Installation

R.H.

Sanitarian