IREDELL COUNTY HEALTH DEPARTMENT

Statesville Phone TR 3-7271 Mooresville Phone NO 3-1271

PERMIT TO INSTALL SEPTIC TANK

Permit NO. Watts Permit Date July 15 1960

Owner Bill Dorsey Address Rt 5 Mt View Echo.

Installed By C Stoke Address R1


Location of Property Right in N.E. left at dead end. 1st on left

Tank		Capacity		Length of Lines		Fixtures	
Block	( )	800	( )	150'	( )	No. of Baths	(2)
Precast	(x)	900	( )	175'	( )	Dishwasher	( )
		1000	( )	200'	( )	Garbage Grdr.	( )
Vault		1100	( )	225'	( )	Auto-Washer	( )
		1200	( )	250'	( )	Other	
		Other 1250		Other 260.			

NOTIFY HEALTH DEPARTMENT AT LEAST EIGHT HOURS BEFORE TANK IS TO BE INSPECTED.

Final Inspection 195_ Approved ( ) Disapproved ( )

Remarks City water - all ditches 5 ft. wide and very deep.

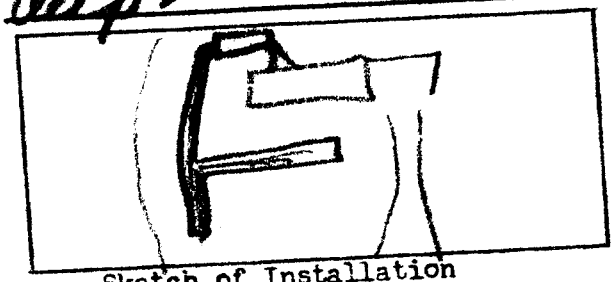

Sketch of Installation

Rt.

checked on by

Wayne R. Thomas

Sanitarian